COUNTY SURVEYORS FILE DATA
DO NOT REMOVE FROM OFFICE

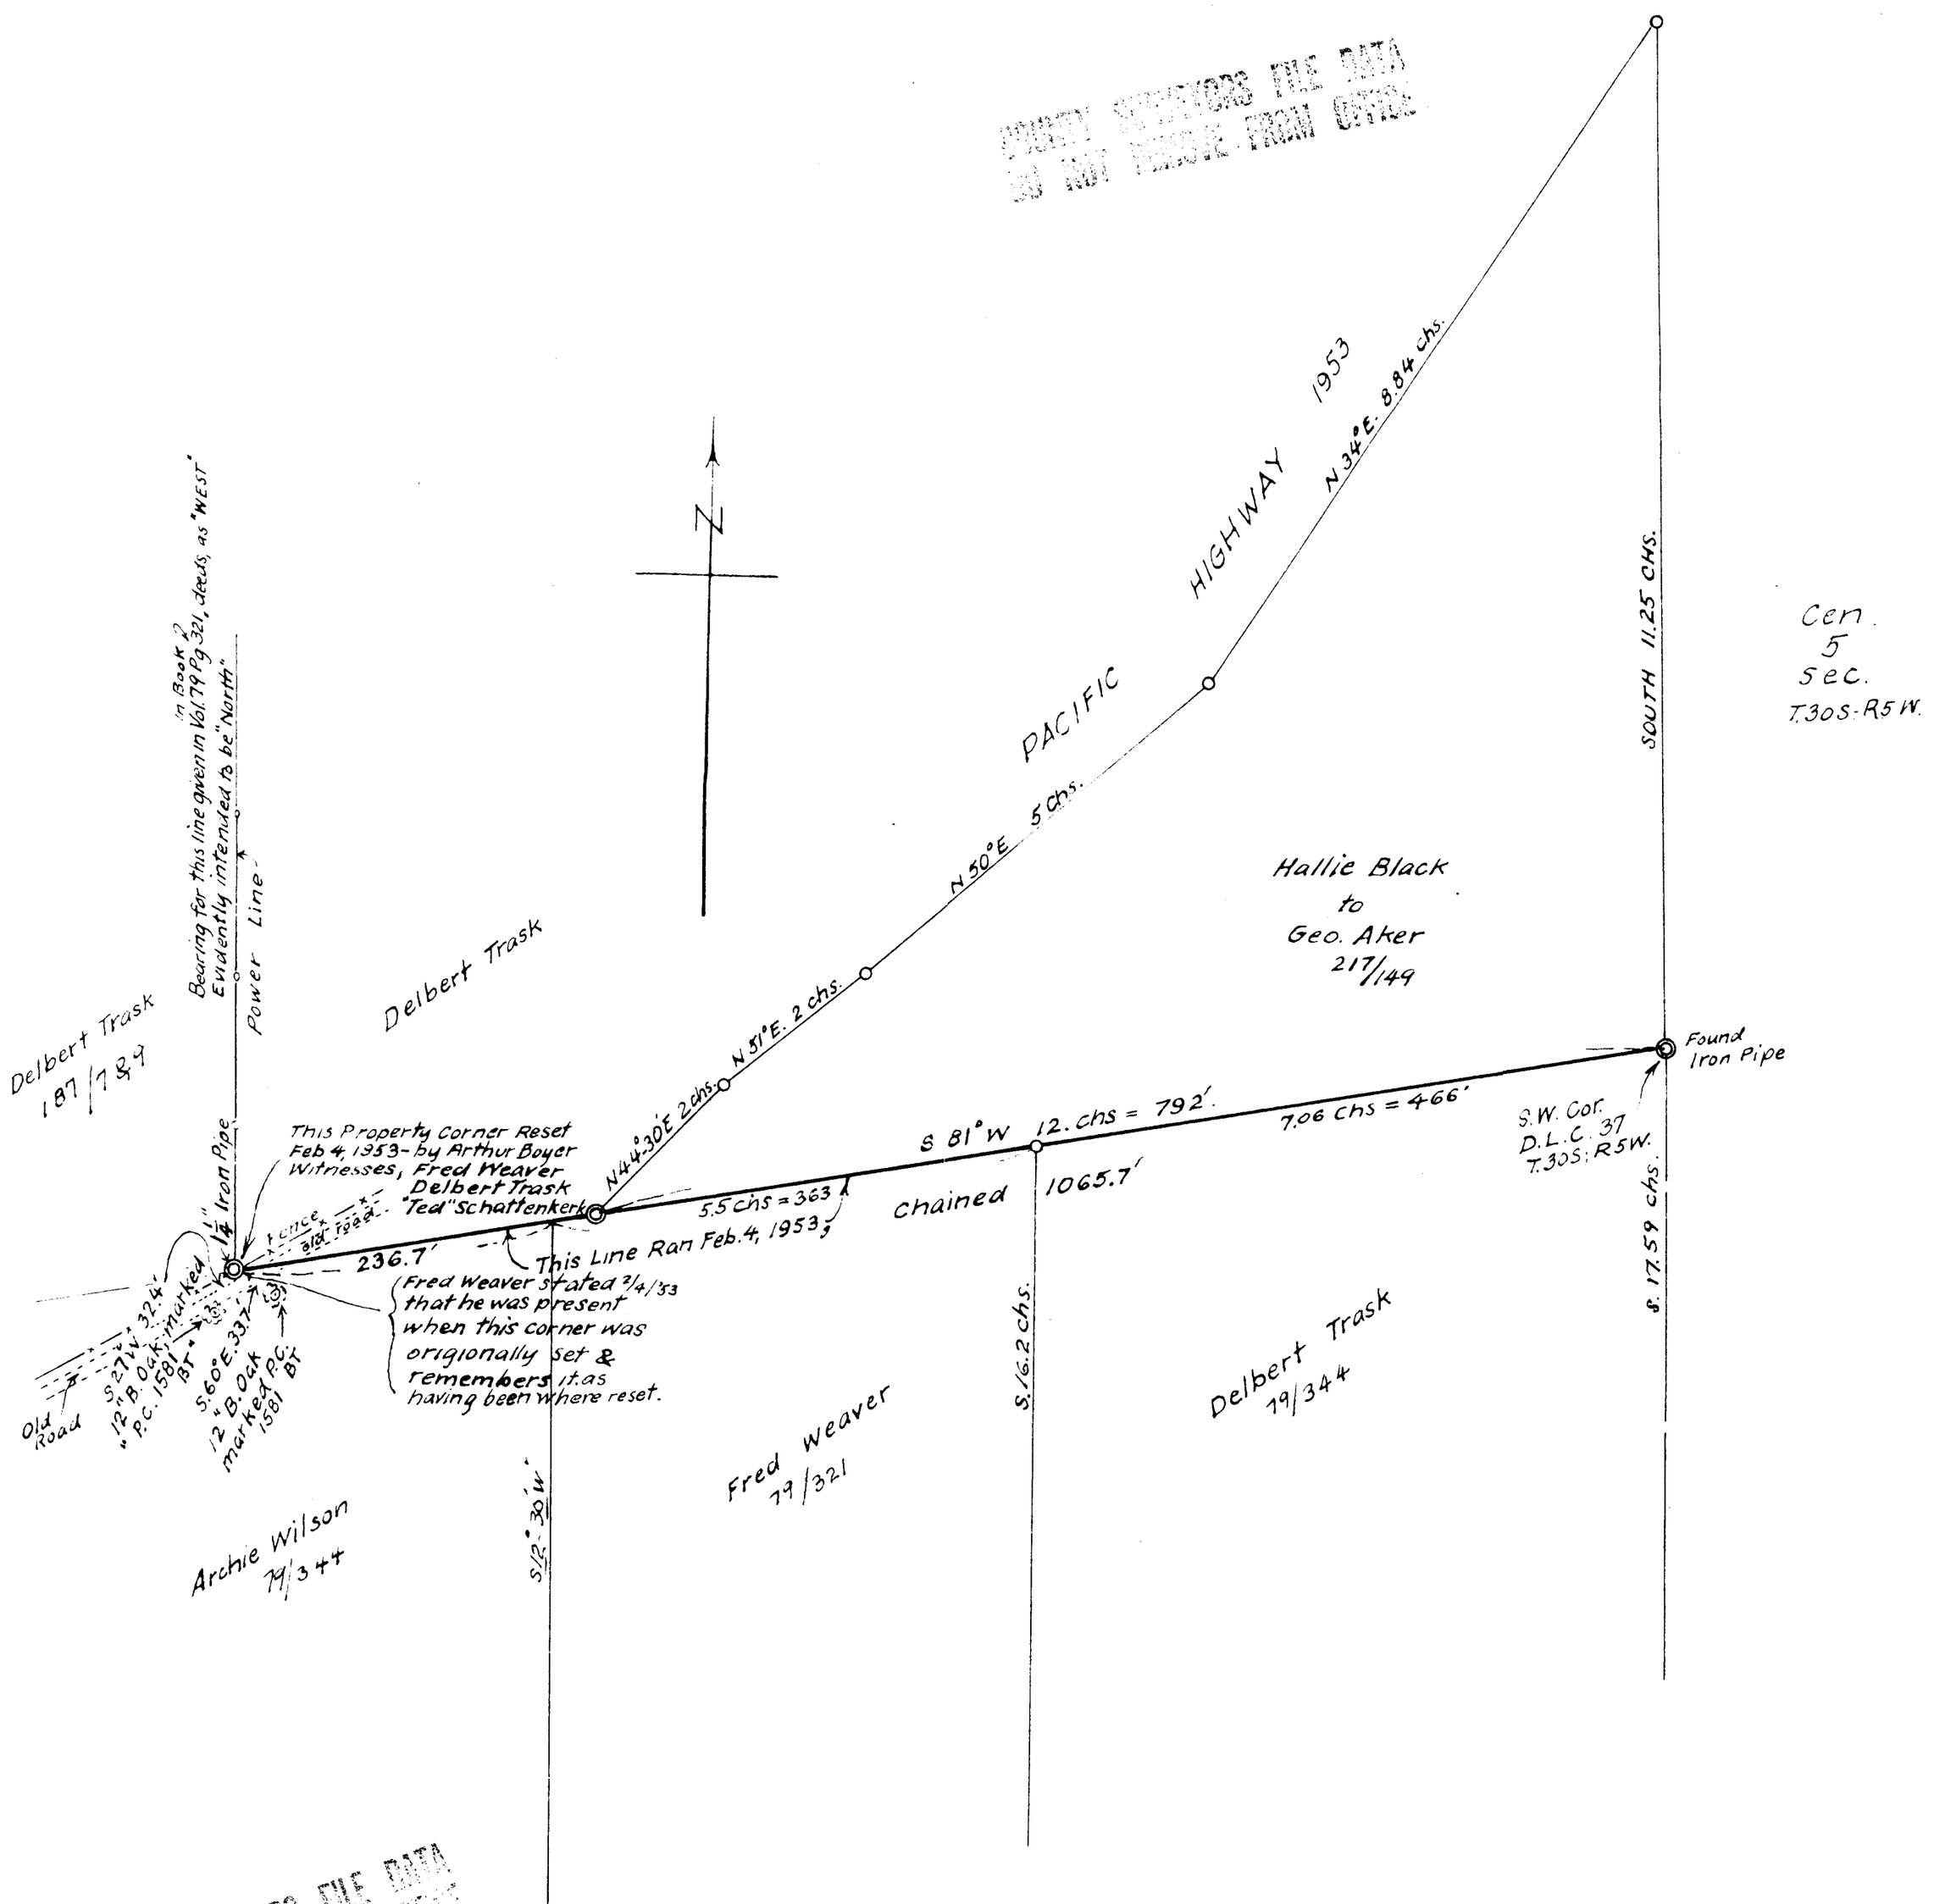

COUNTY SURVEYORS FILE DATA
DO NOT REMOVE FROM OFFICE

FILED 41-132
RECEIVED
MAR 12 1953
COUNTY SURVEYOR
DOUGLAS COUNTY, ORE.

LINE BET GEO. AKER & FRED WEAVER &
DELBERT TRASK IN SEC 5, T.30S; R 5W, W.M.
Feb. 1953 A. Boyer 1" = 100 ft.

File No. 41/132