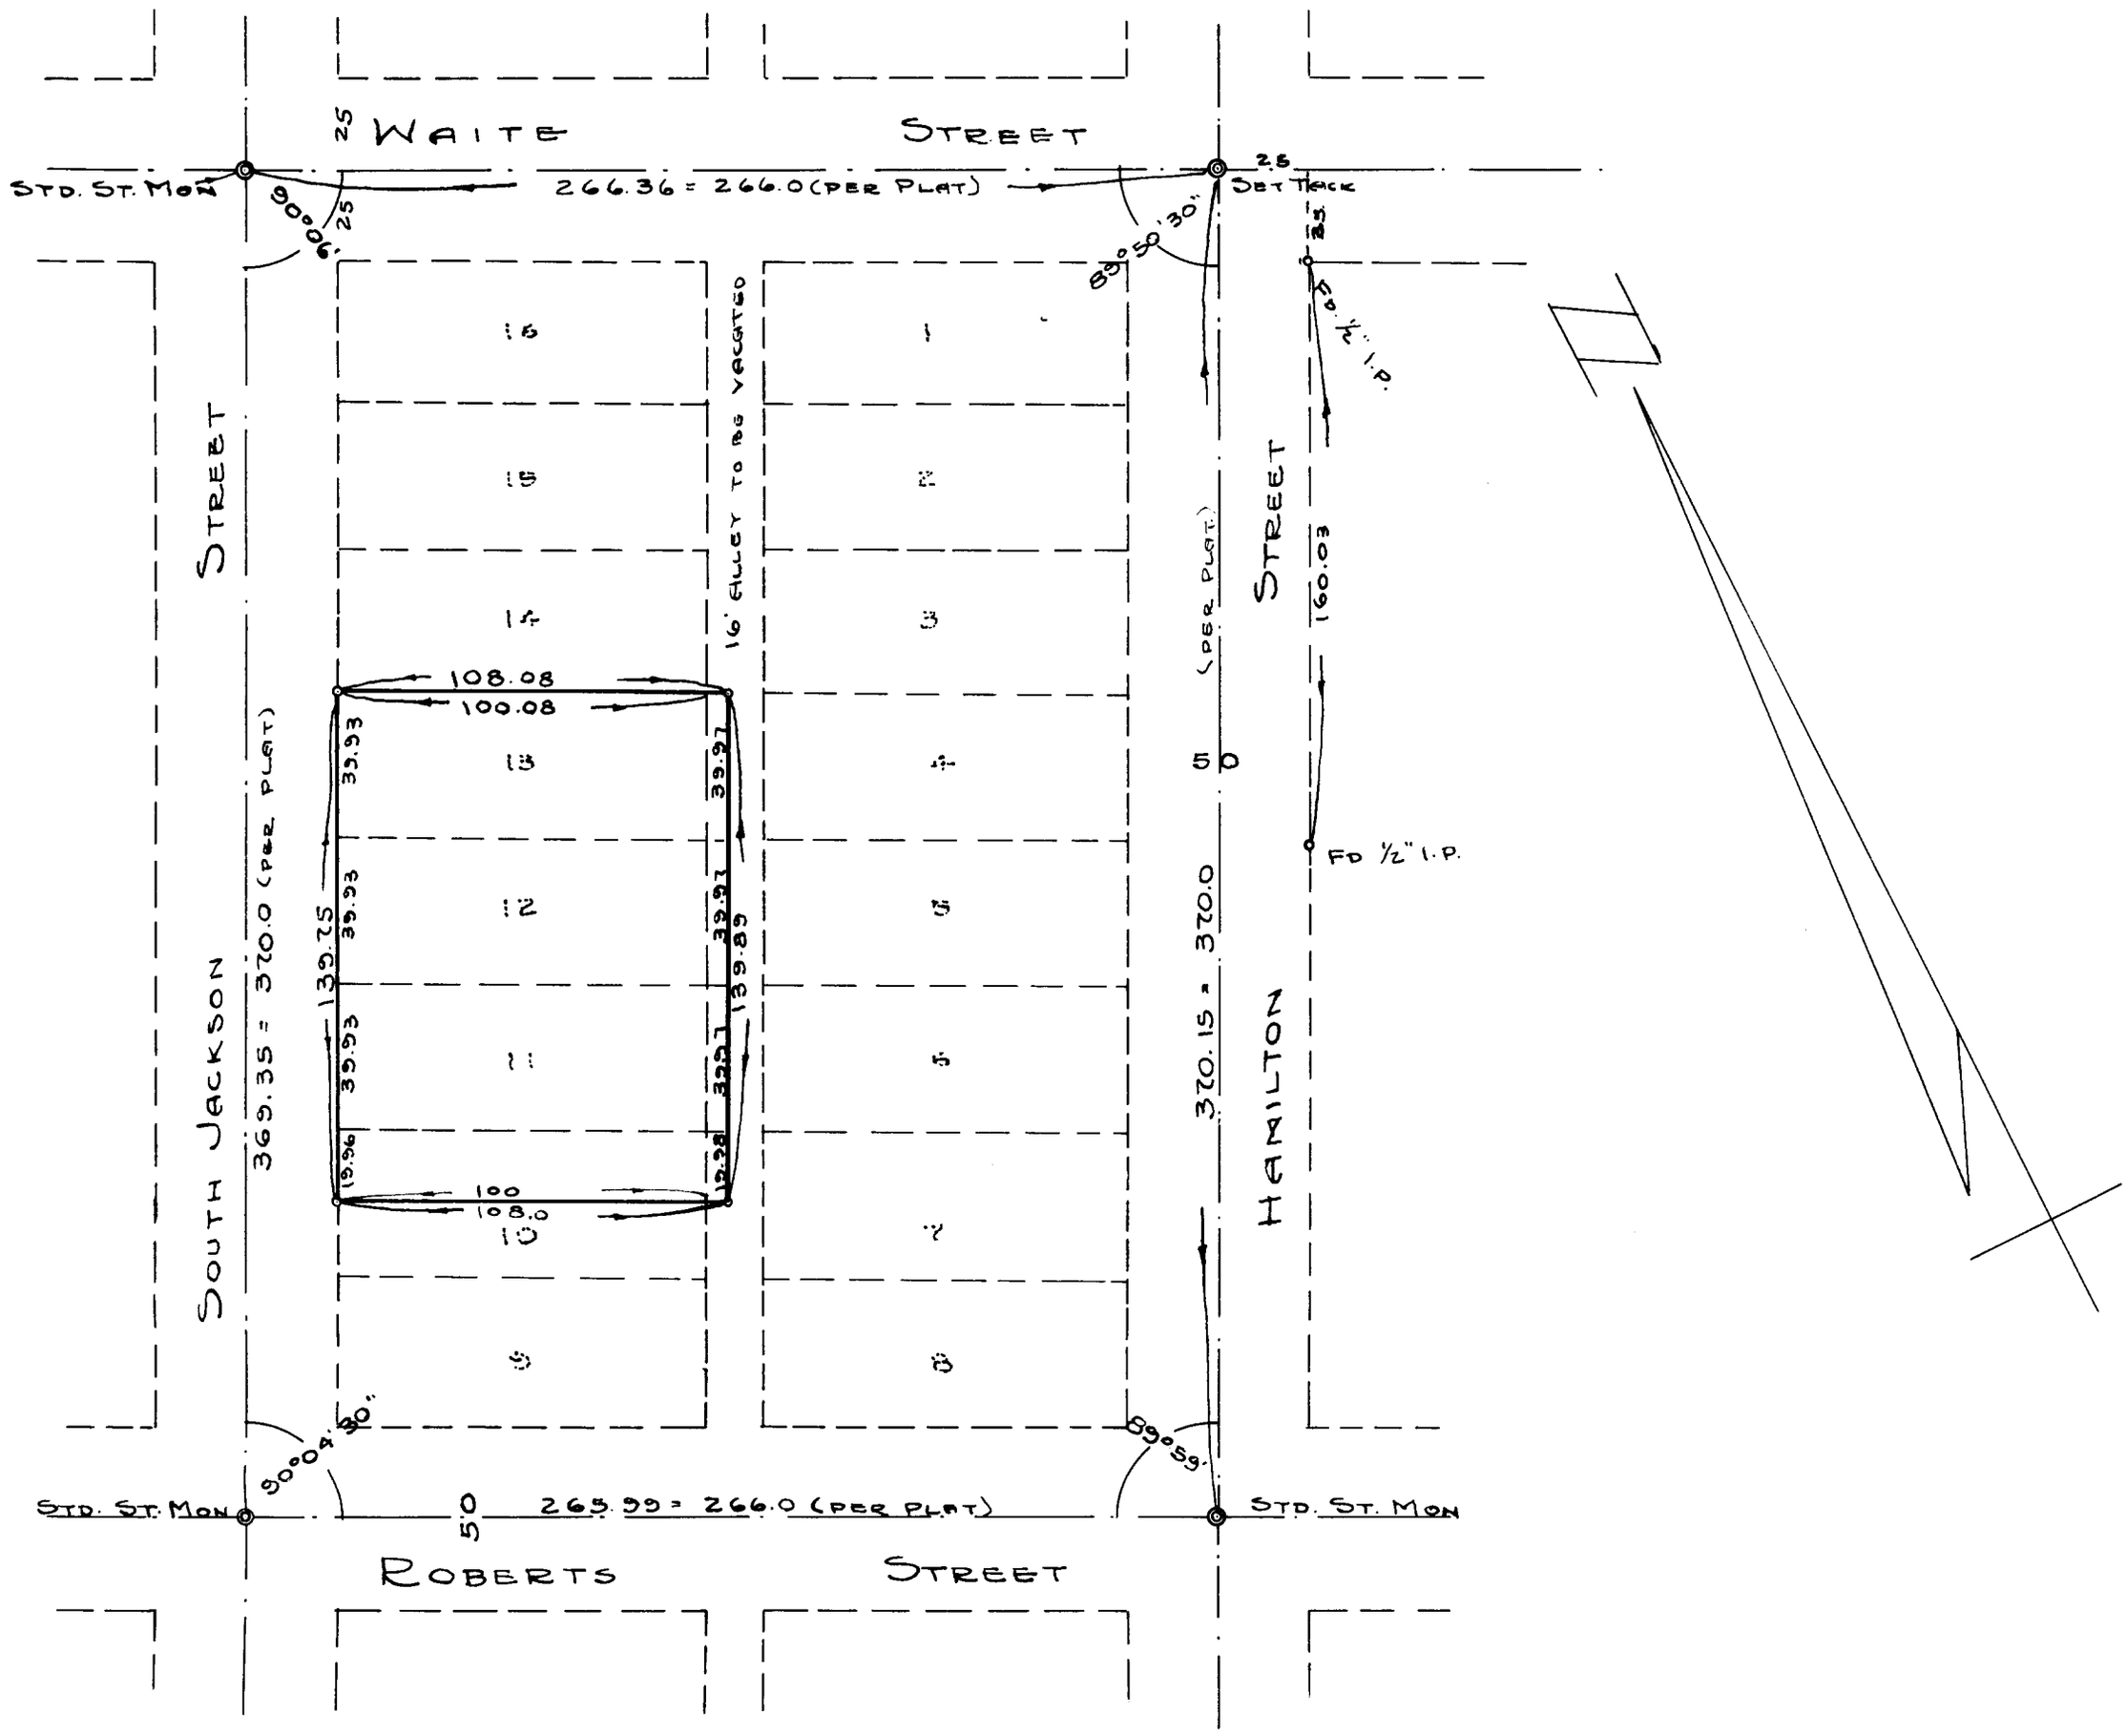

SURVEY TO SET PROPERTY CORNERS
NORTH ½ LOT 10 & LOTS 11, 12 & 13, BLOCK 13
WAITE'S ADD'N TO ROSEBURG OREGON

GRANT AND EVANS, ENGINEERS
ROSEBURG OREGON
SURVEYED 3-14-53 SCALE 1" 50'

COUNTY SURVEYORS FILE DATA
DO NOT REMOVE FROM OFFICE