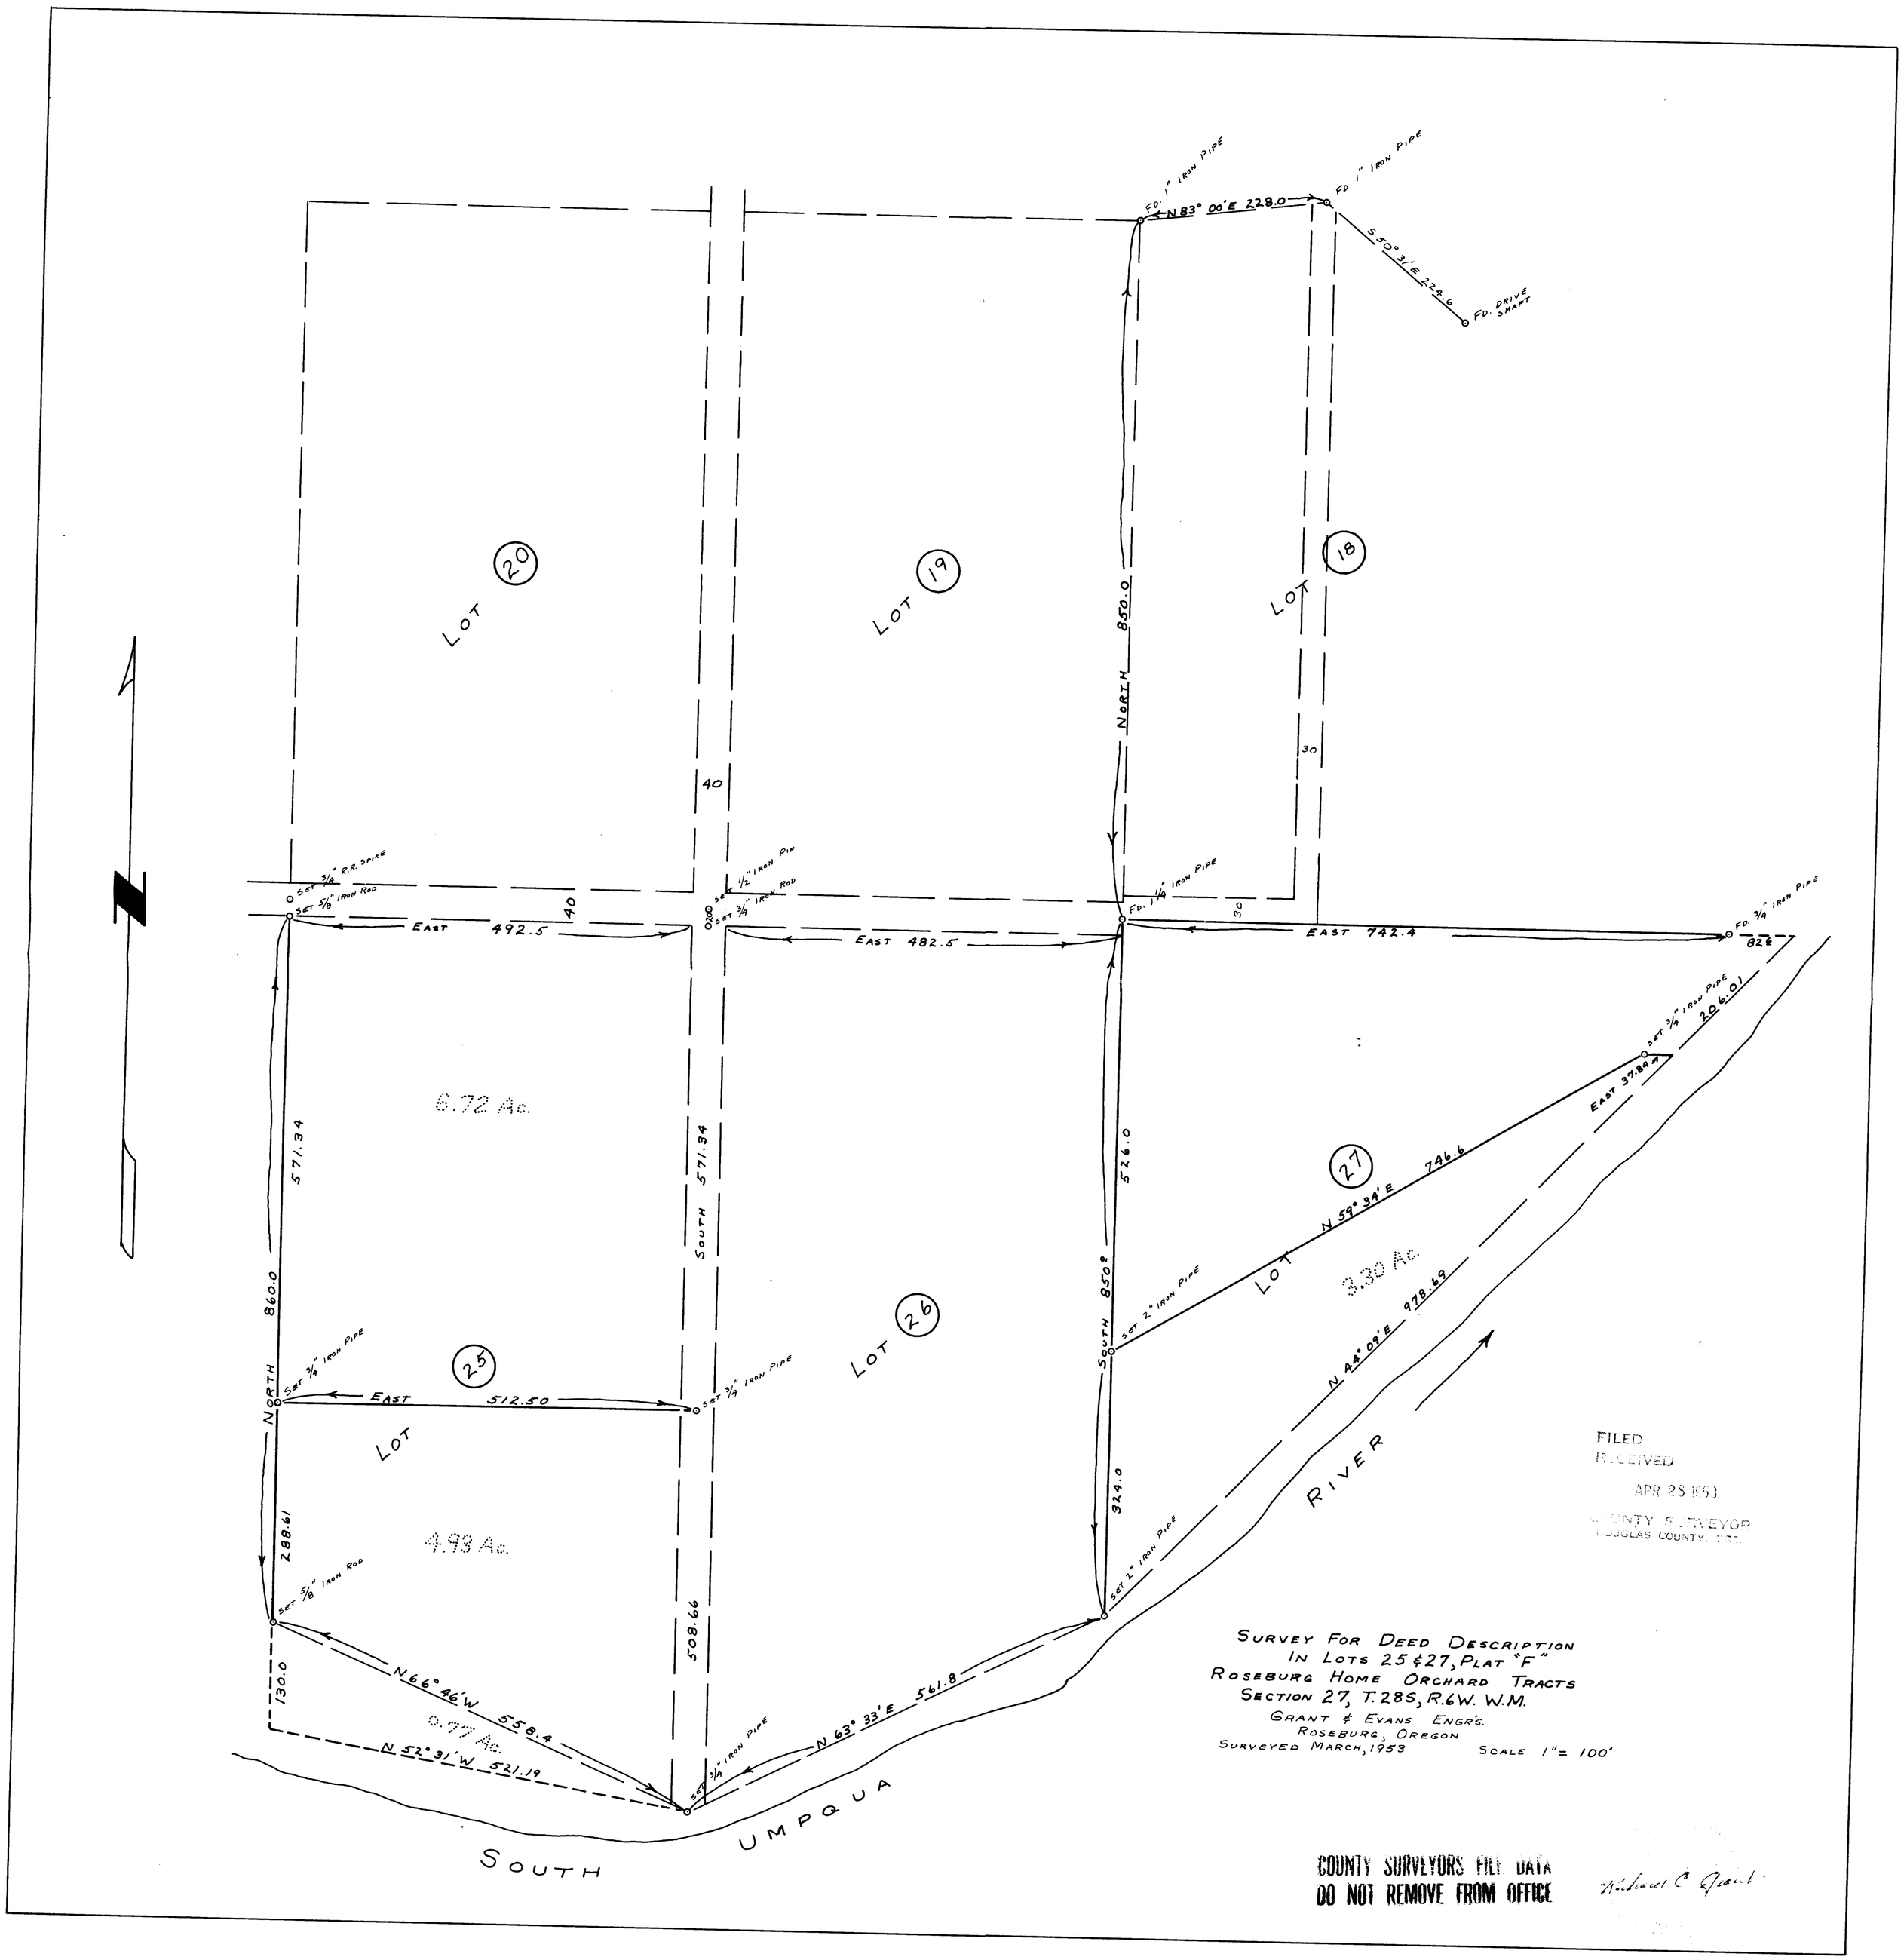

FILED
RECEIVED
APR 28 1953
COUNTY SURVEYOR
DOUGLAS COUNTY, ORE.

SURVEY FOR DEED DESCRIPTION
IN LOTS 25 & 27, PLAT "F"
ROSEBURG HOME ORCHARD TRACTS
SECTION 27, T.28S, R.6W. W.M.
GRANT & EVANS ENGR'S.
ROSEBURG, OREGON
SURVEYED MARCH, 1953 SCALE 1" = 100'

COUNTY SURVEYORS FILE DATA
DO NOT REMOVE FROM OFFICE

Richard C. Grant

CS 41/149