COUNTY SURVEYORS FILE DATA
DO NOT REMOVE FROM OFFICE

# SURVEY FOR DEED DESCRIPTION
## SECTION 5, T25S., R5W.W.M.
## DOUGLAS COUNTY, ORE.

FILED
RECEIVED
JUN 29 1953
COUNTY SURVEYOR
DOUGLAS COUNTY, ORE.

GRANT & EVANS, ENGINEERS
ROSEBURG, OREGON
SURVEYED JUNE 1953
SCALE 1" = 50'

REGISTERED PROFESSIONAL ENGINEER
2741
OREGON
NOV. 7, 1947
ARTHUR R. EVANS

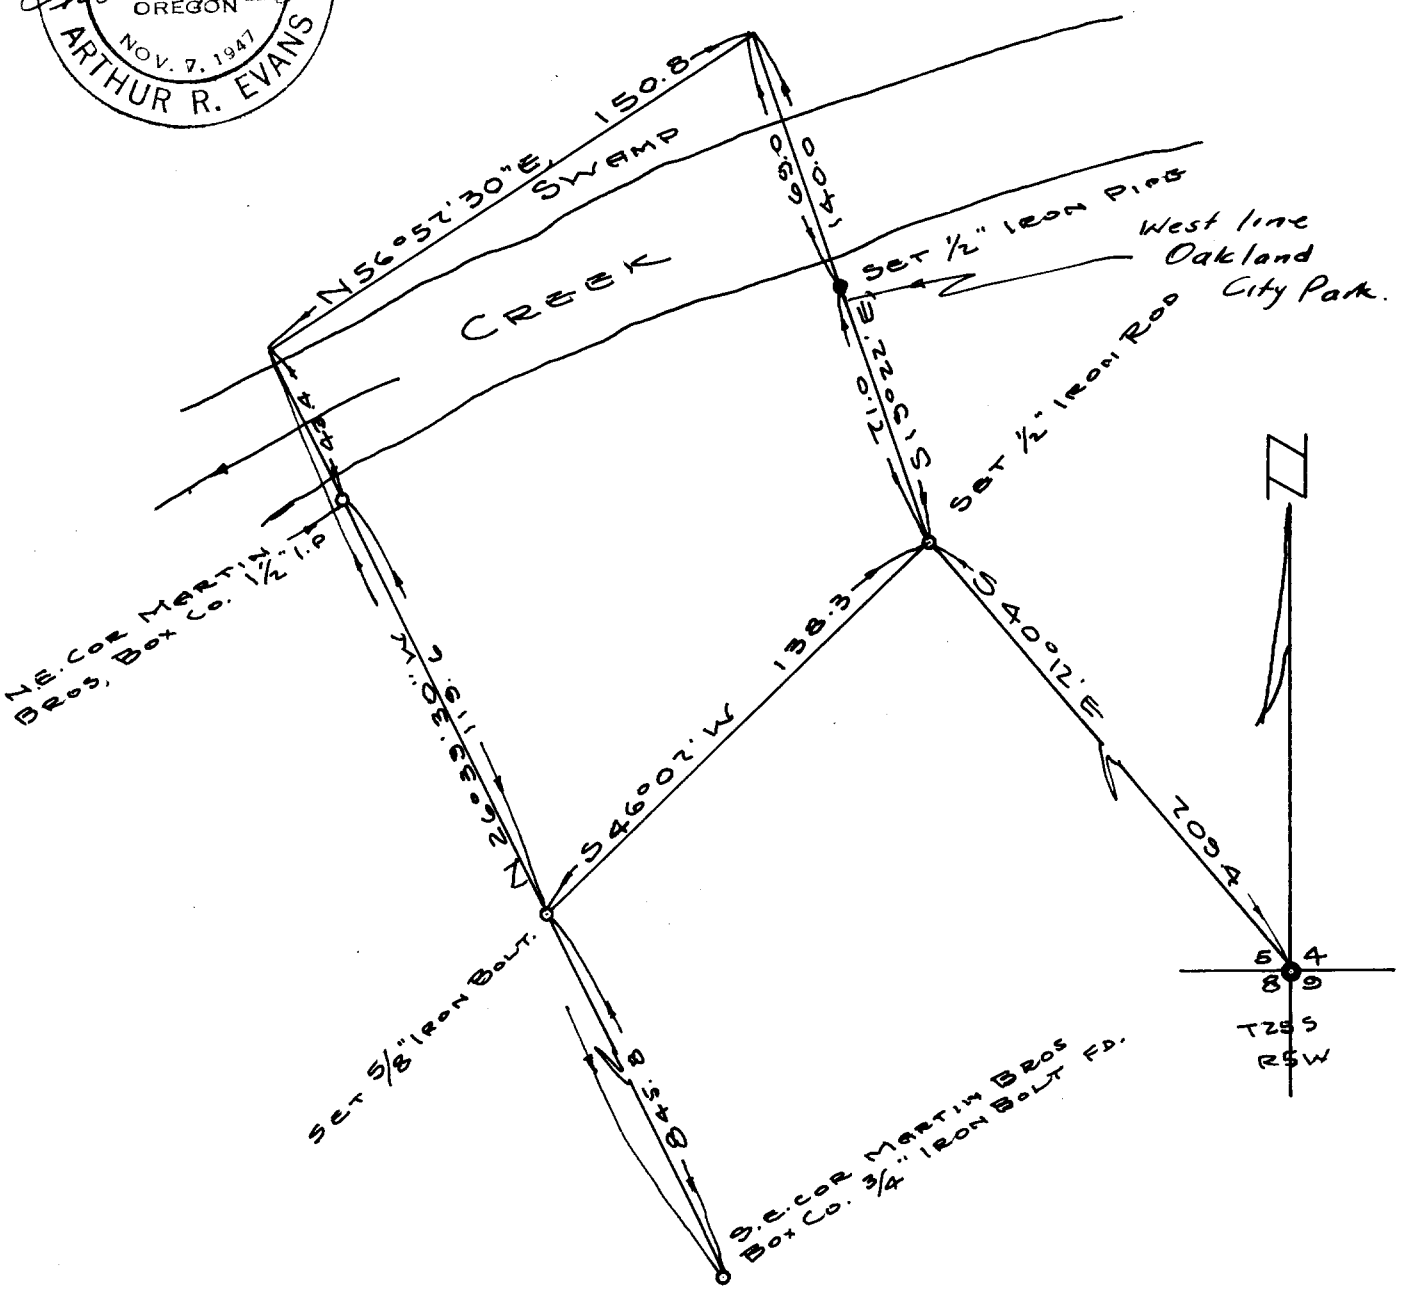


GEORGE CLAWSON

P 41/166

2