COUNTY SURVEYORS FILE DATA
DO NOT REMOVE FROM OFFICE

- SURVEY FOR DEED DESCRIPTIONS IN CHADWICK ADD'N TO ROSEBURG, ORE.

REGISTERED PROFESSIONAL ENGINEER 2741 OREGON NOV. 7, 1947 ARTHUR R. EVANS

GRANT AND EVANS, ENGINEERS
ROSEBURG OREGON

SURVEYED MAY 1953
SCALE 1" = 50'
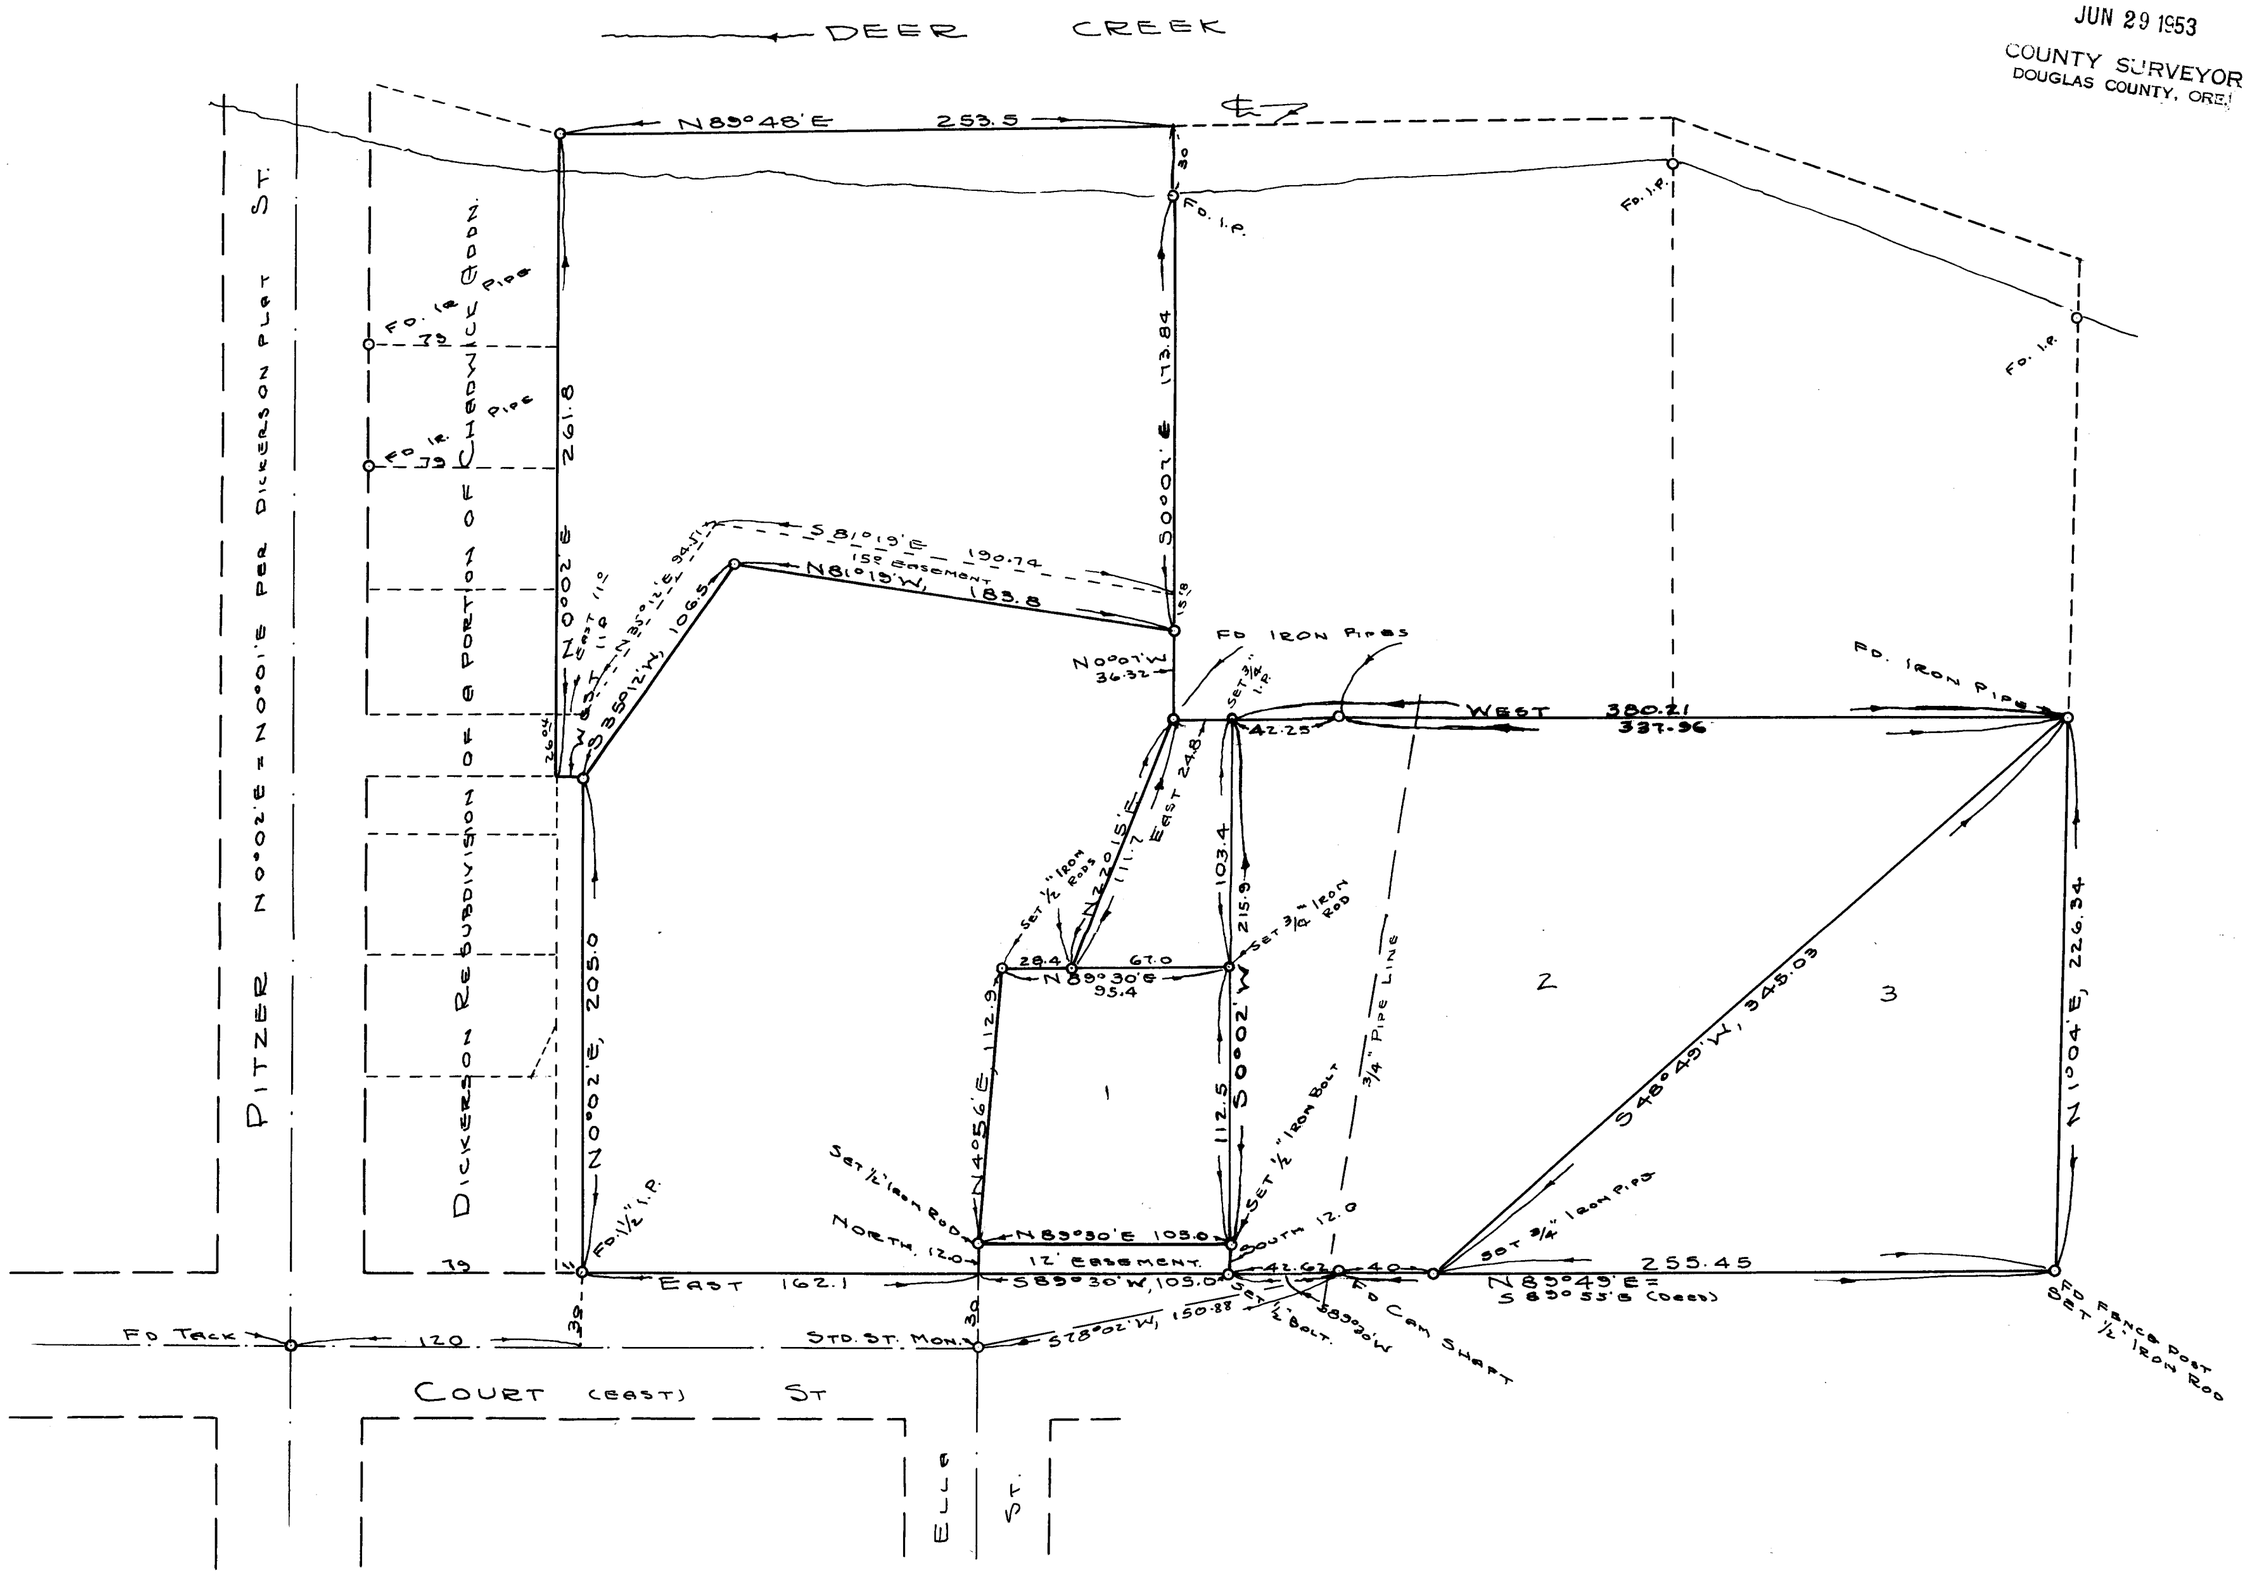
FILED
RECEIVED
JUN 29 1953
COUNTY SURVEYOR
DOUGLAS COUNTY, ORE.