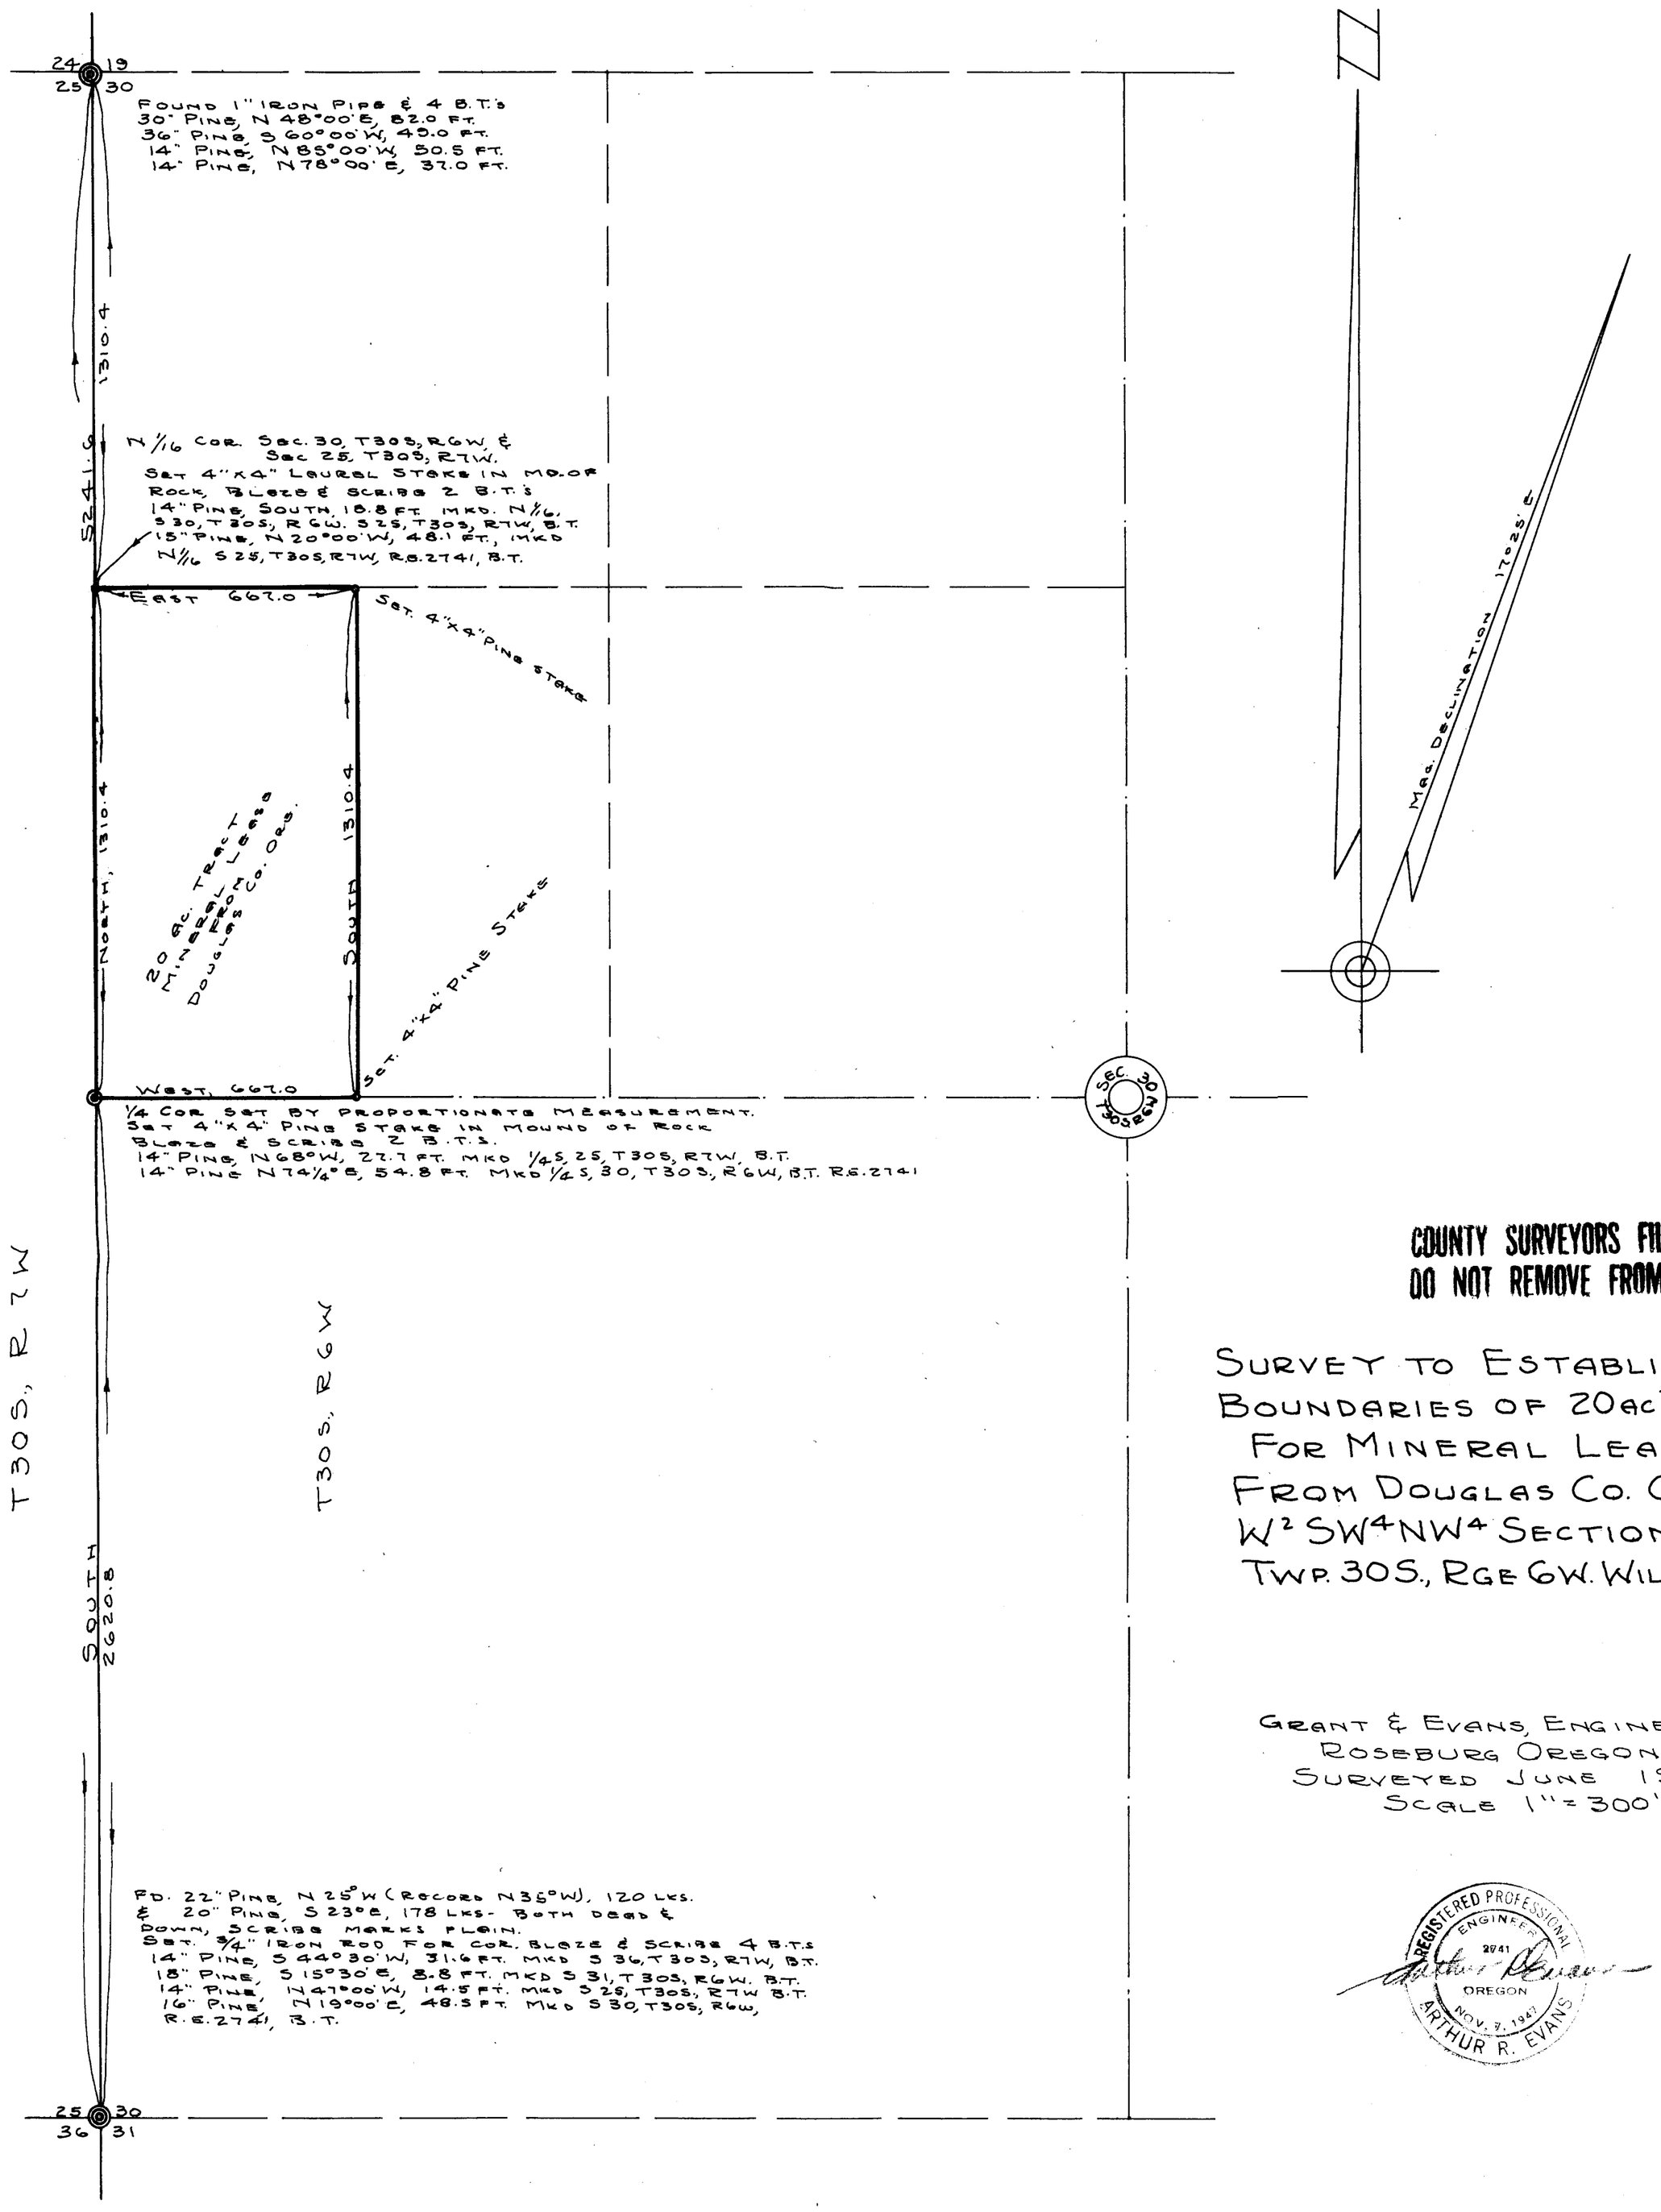

COUNTY SURVEYORS FILE DATA
DO NOT REMOVE FROM OFFICE

SURVEY TO ESTABLISH BOUNDARIES OF 20 AC TRACT FOR MINERAL LEASE FROM DOUGLAS CO. ORE., W½ SW¼ NW¼ SECTION 30 TWP. 30S., RGE 6W. WIL. MER.

GRANT & EVANS, ENGINEERS
ROSEBURG OREGON
SURVEYED JUNE 1953
SCALE 1" = 300'

REGISTERED PROFESSIONAL ENGINEER 2741 OREGON NOV. 7, 1947 ARTHUR R. EVANS

FILED
RECEIVED
JUN 29 1953
COUNTY SURVEYOR
DOUGLAS COUNTY, ORE.