


ARTHUR BOYER
ROSEBURG, OREGON

July 16, 1953

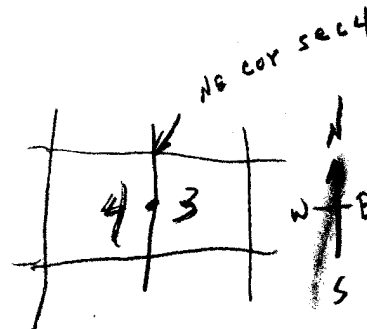

Mr Beb B. Irving,
County Surveyor.

Dear Sir,-

The following is a description of the location of the quarter section corner bet. secs. 3 & 4, T.28S; 8 W; W.M; which has been obliterated, the witness trees were both hemlocks and no evidence of them could be found although there were old dead trees and the stump holes that seemed to check out but it was impossible to tell whether they were fir or hemlock, there were no standing hemlocks of the required age which would have been about 97 yrs. There is a line of blazes on older trees from the south but while they were old it was not possible to tell whether they were the original ones. For the above reasons the cor, was set on a line between the sec. corners to the N. & S. running from the north end towards the south east cor. of 4. The N.E. cor. of 4 is at the top of a high rock bluff, both the B.T's are still standing, (cedars) and are 300 ft. W. of a govt. yellow tag which is on a gov't trail rather close to it. A random line was run from this sec. cor. southerly and at the half mile a search was made for the 1/4 cor. without success, the line was continued southerly and at a point 5217.0 ft. S. and 141.4 ft. E. the S.E. cor. of 4 was found which is in good condition, all trees standing. From here returned to look for 1/4 cor. again but unable to locate it so set a fir post at the proper proportional dist. using 40 chs for the S. half and 40.4 chs. for the north, making it at 2595.0 ft. N. of the S.E. cor of 4, on a true line bet the two ~~cor.~~ of this sec. 4. Set a 4" x 4" fir post and scribed a 10" hemlock 1/4 S.3, 1581 B.T. S.71°E. 20.0 ft. and a 15" Fir 1/4 S/4, 1581 B.T. This was done on July 16, 1953 Witness was Don. Smith. The fir witness tree might be a little hard to see it is placed so that there is a smaller fir bet. it and the corner but it is blazed. This 1/4 cor. is in flat with no large trees, mostly small second growth firs and small hemlocks and not much underbrush, some rhodendron, there are many medium sized dead and badly decayed windfalls in this area. Blazed out line bet 3 & 4.

Arthur Boyer
ARTHUR BOYER

JUL 13 1953

COUNTY SURVEYOR
DOUGLAS COUNTY, ORE.

T285, R8W.

C.S. FILE NO. 41/176