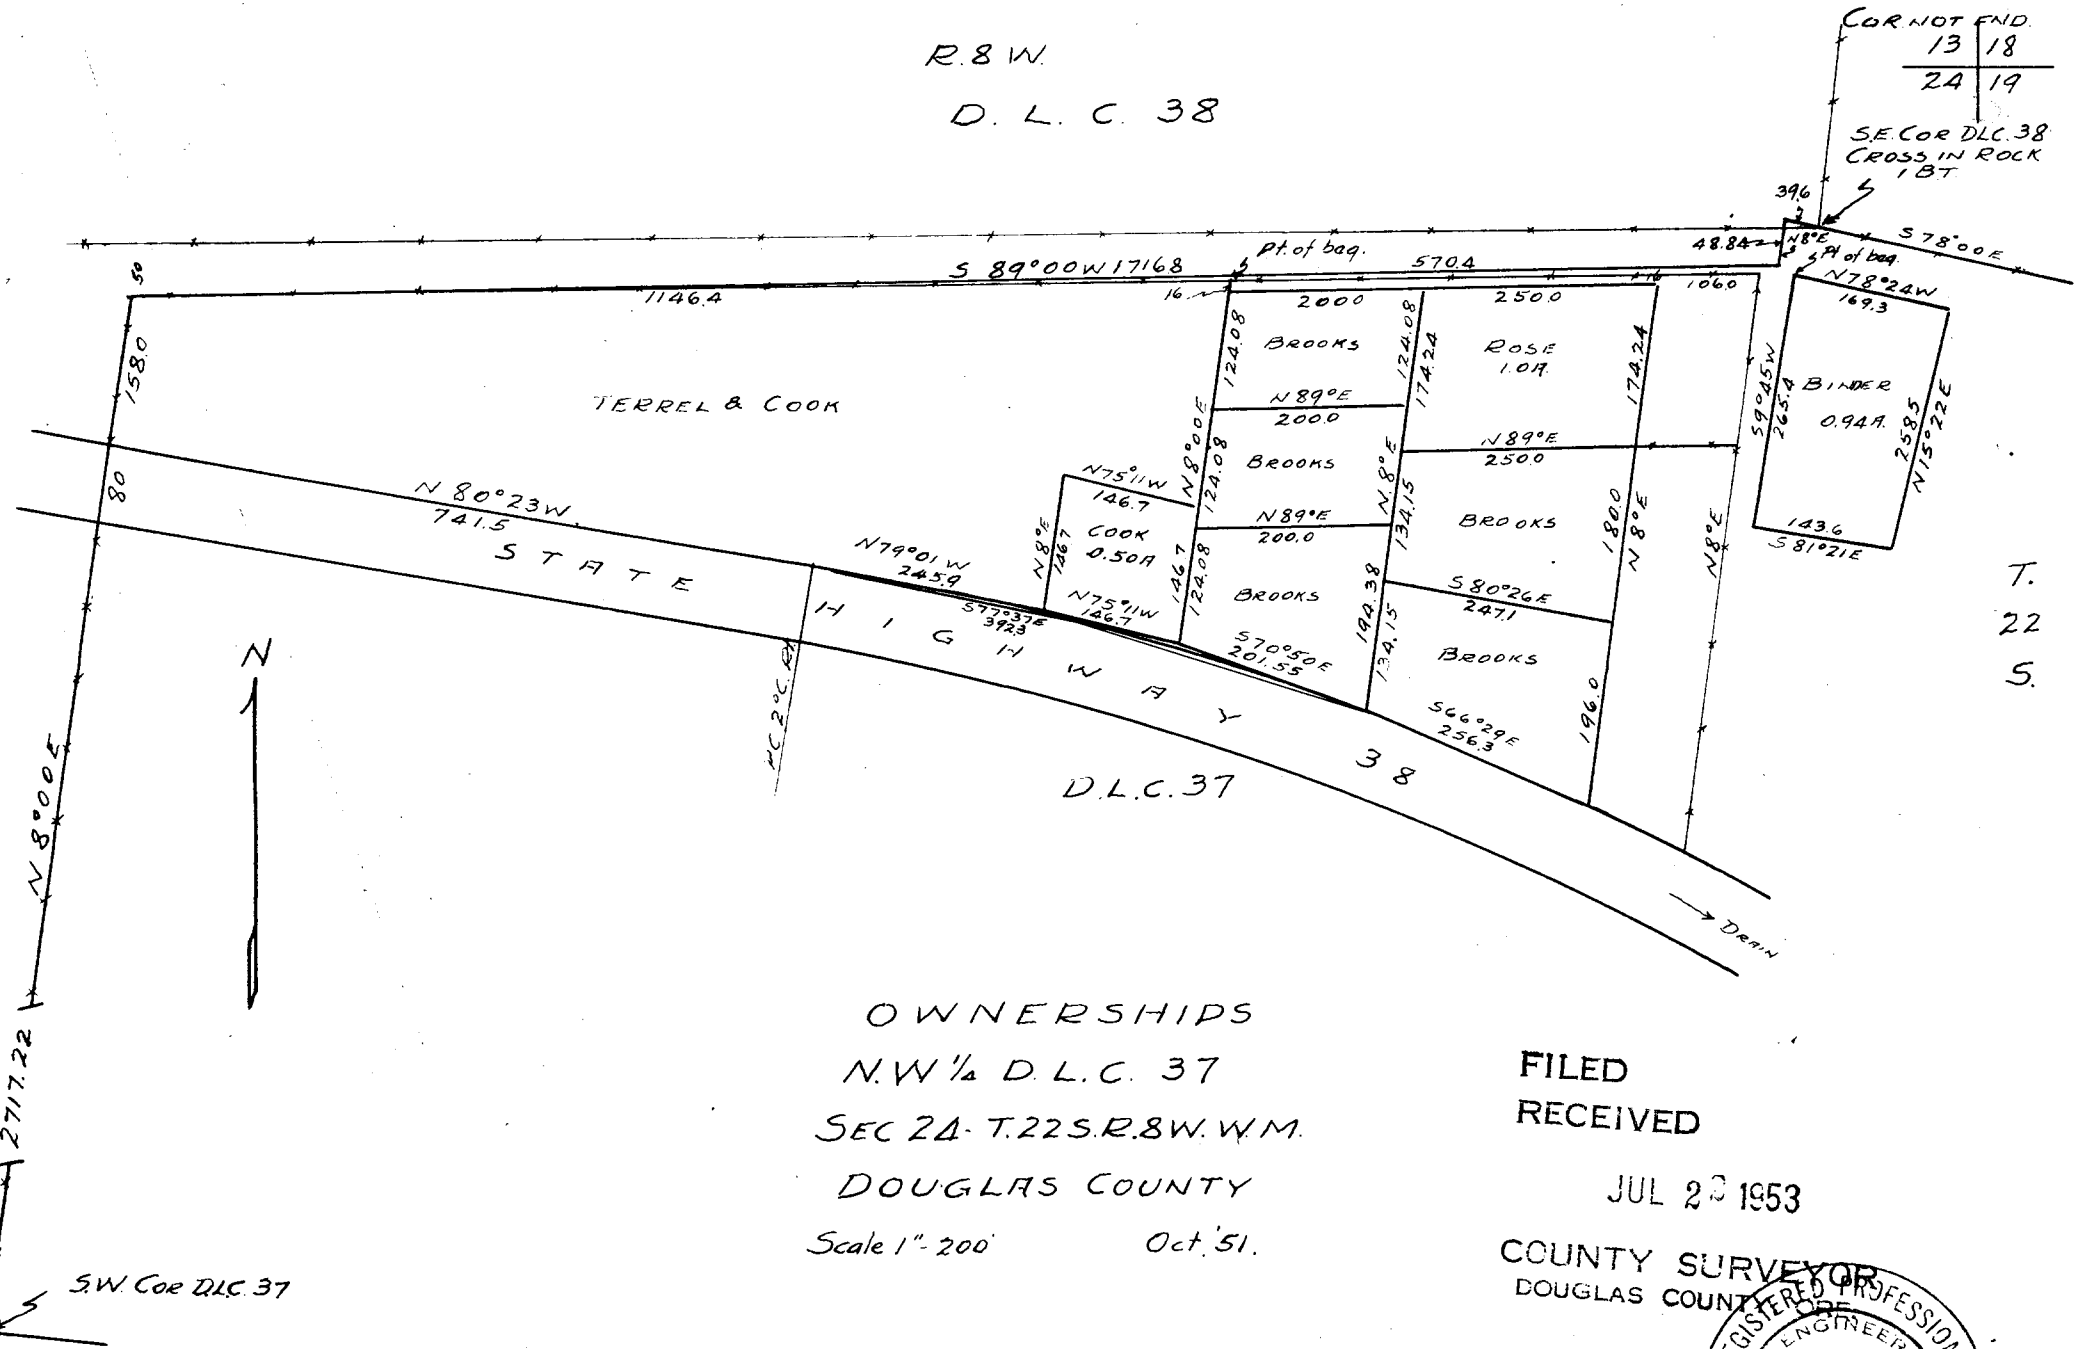

OWNERSHIPS
N.W ¼ D.L.C. 37
SEC 24 - T.22S.R.8W.W.M.
DOUGLAS COUNTY
Scale 1" = 200' Oct. '51.

FILED
RECEIVED
JUL 20 1953
COUNTY SURVEYOR
DOUGLAS COUNTY, ORE.

REGISTERED PROFESSIONAL ENGINEER
OREGON
MARCH 5, 1948
WM. J. BRAYTON

COUNTY SURVEYORS FILE DATA
DO NOT REMOVE FROM OFFICE

41/178