NOTE: o DENOTES 1/2" IRON PIN SET

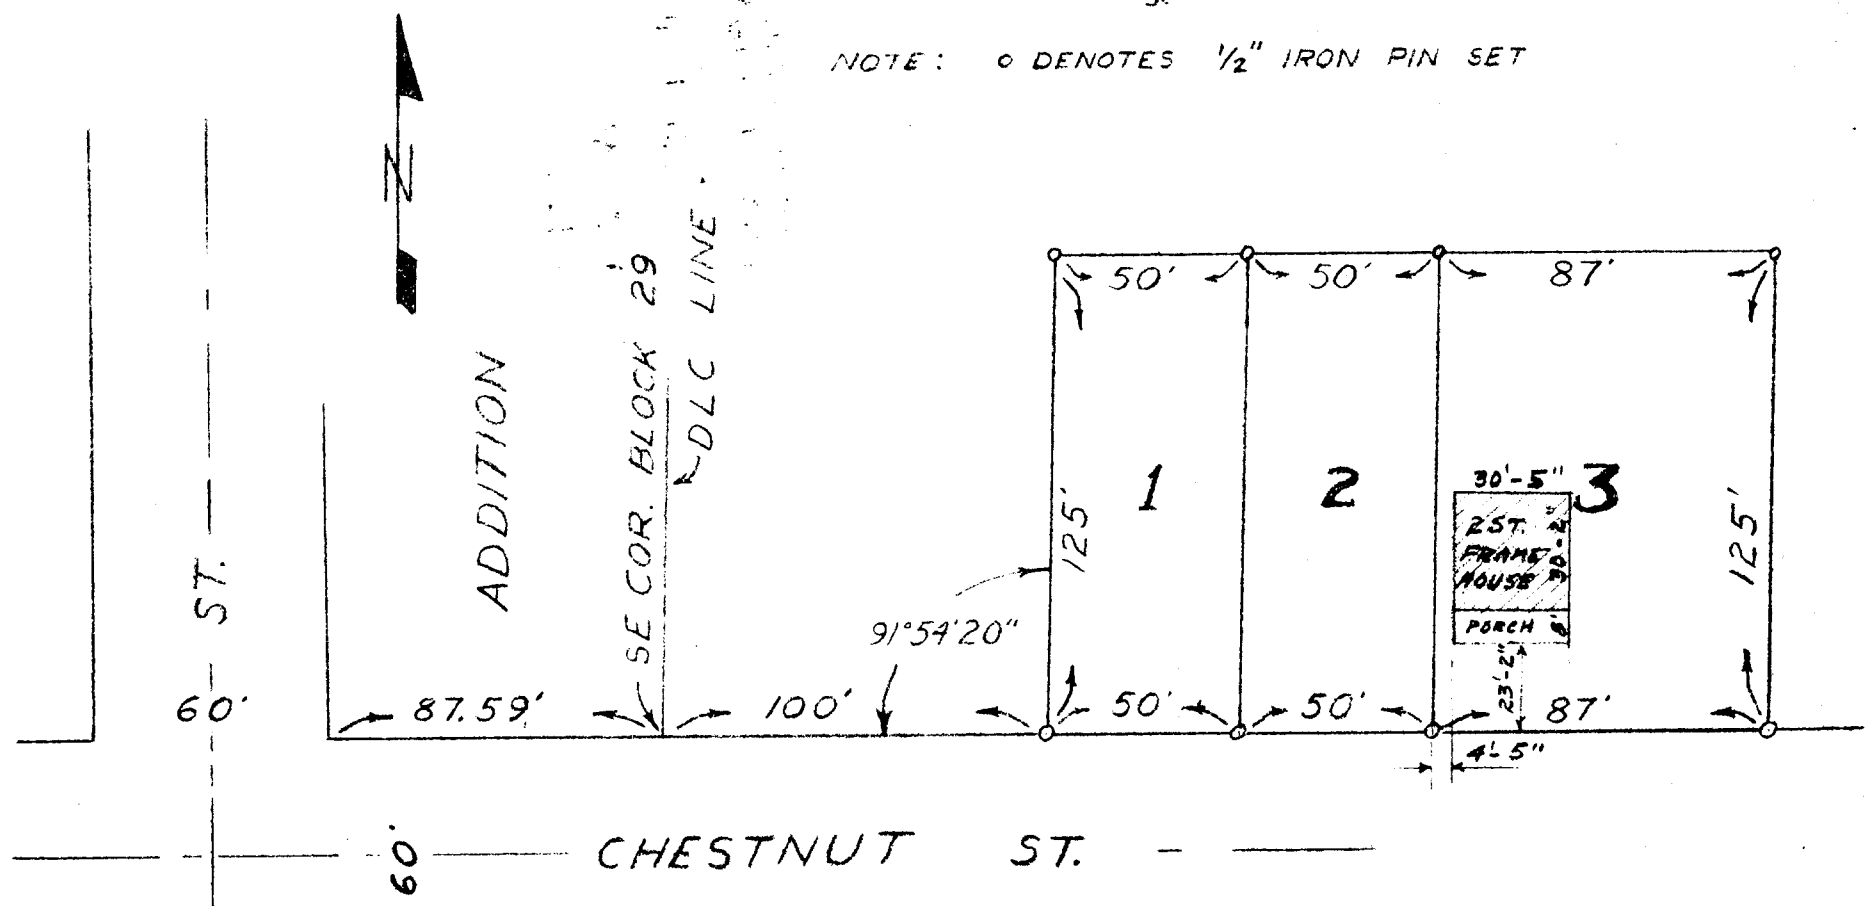

FILED
RECEIVED
OCT 3 1949
COUNTY SURVEYOR
DOUGLAS COUNTY, ORE.

REGISTERED PROFESSIONAL ENGINEER 2139 OREGON NOV. 19, 1944 JAMES R. DAUGHERTY

J. R. Daugherty

MAX SEITZ
ROSEBURG OREGON

JAMES R. DAUGHERTY
CIVIL-SANITARY ENGINEER
REGISTERED PROFESSIONAL ENGINEER
ROSEBURG OREGON

DATE: Nov. 30, 48 | SCALE: 1" = 50'