P.E. BLACK PARCEL

COUNTY SURVEYORS FILE DATA
DO NOT REMOVE FROM OFFICE

N. MYRTLE CREEK ROAD

SECT. 18 · T29S · R4W · W.M.

DOUGLAS COUNTY
OREGON

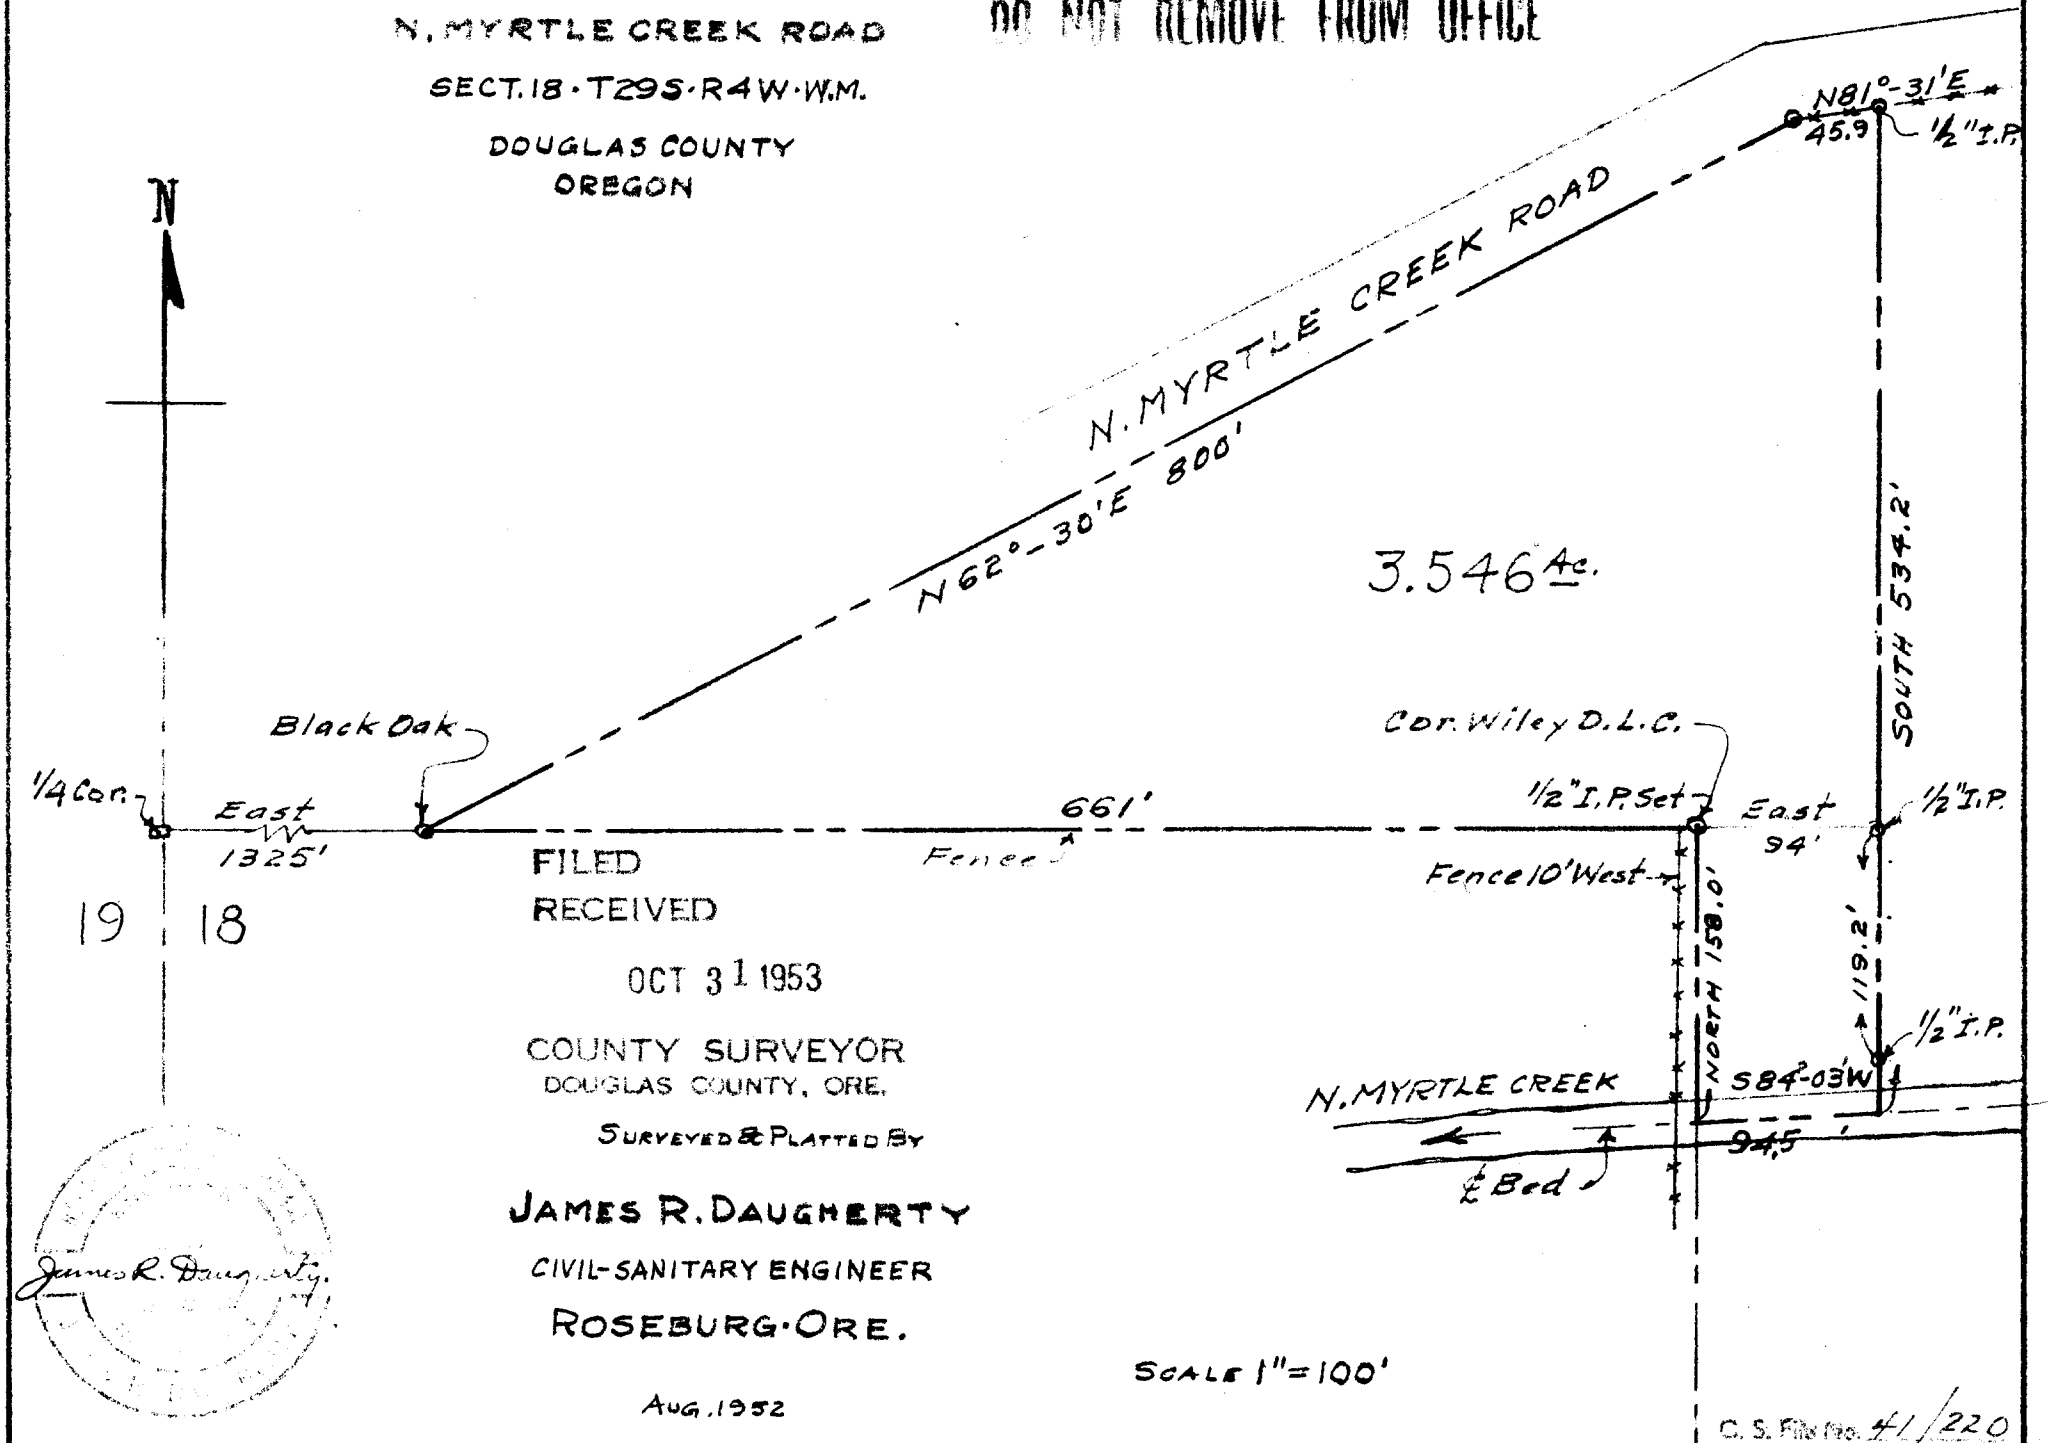

FILED
RECEIVED
OCT 31 1953
COUNTY SURVEYOR
DOUGLAS COUNTY, ORE.

SURVEYED & PLATTED BY

JAMES R. DAUGHERTY
CIVIL-SANITARY ENGINEER
ROSEBURG · ORE.

James R. Daugherty

AUG. 1952

SCALE 1" = 100'

C. S. File No. 41/220