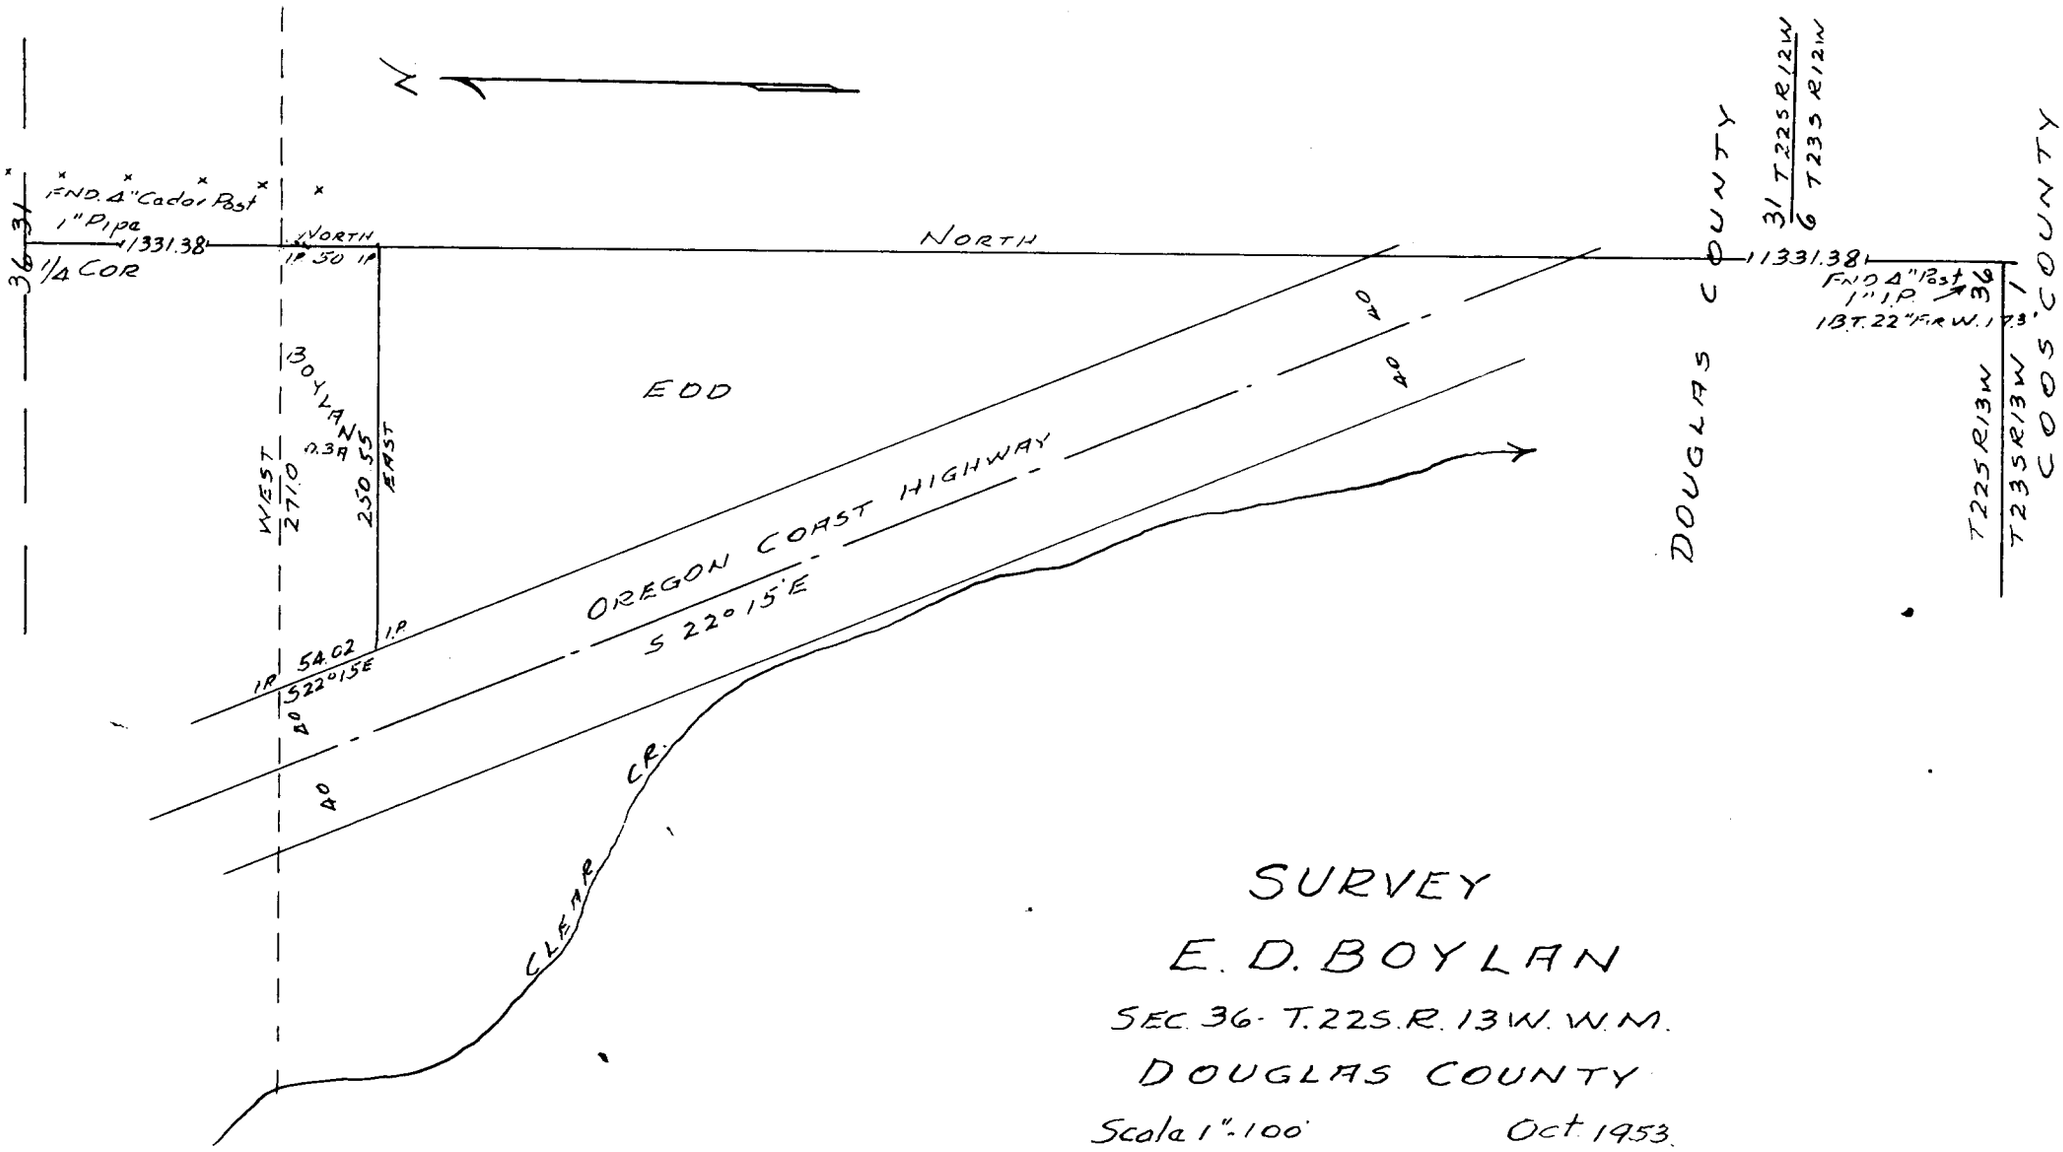


SURVEY

E. D. BOYLAN

SEC. 36 - T. 22S. R. 13W. W.M.

DOUGLAS COUNTY

Scale 1" = 100'  Oct. 1953.

Wm. J. Brayton

COUNTY SURVEYORS FILE DATA
DO NOT REMOVE FROM OFFICE

FILED
RECEIVED
NOV 16 1953
COUNTY SURVEYOR
DOUGLAS COUNTY, ORE.

C.S. FILE 41/232