COUNTY SURVEYORS FILE DATA
DO NOT REMOVE FROM OFFICE

FILED
RECEIVED
MAY 11 1954
COUNTY SURVEYOR
DOUGLAS COUNTY, ORE.

SURVEY TO ESTABLISH PROPERTY LINES EASTERLY 110 FEET OF LOT 1, BLOCK 2 OF BEULAH ADDITION TO ROSEBURG, ORE.

LOCATED IN SEC. 18, T. 27S., R. 5W.; W. M.
DOUGLAS COUNTY, OREGON

FOR

DOUGLAS COUNTY REAL ESTATE

GRANT, EVANS & JOHNSON - ENGINEERS
ROSEBURG, OREGON
SURVEYED MARCH 26, 1954 SCALE 1" = 50'

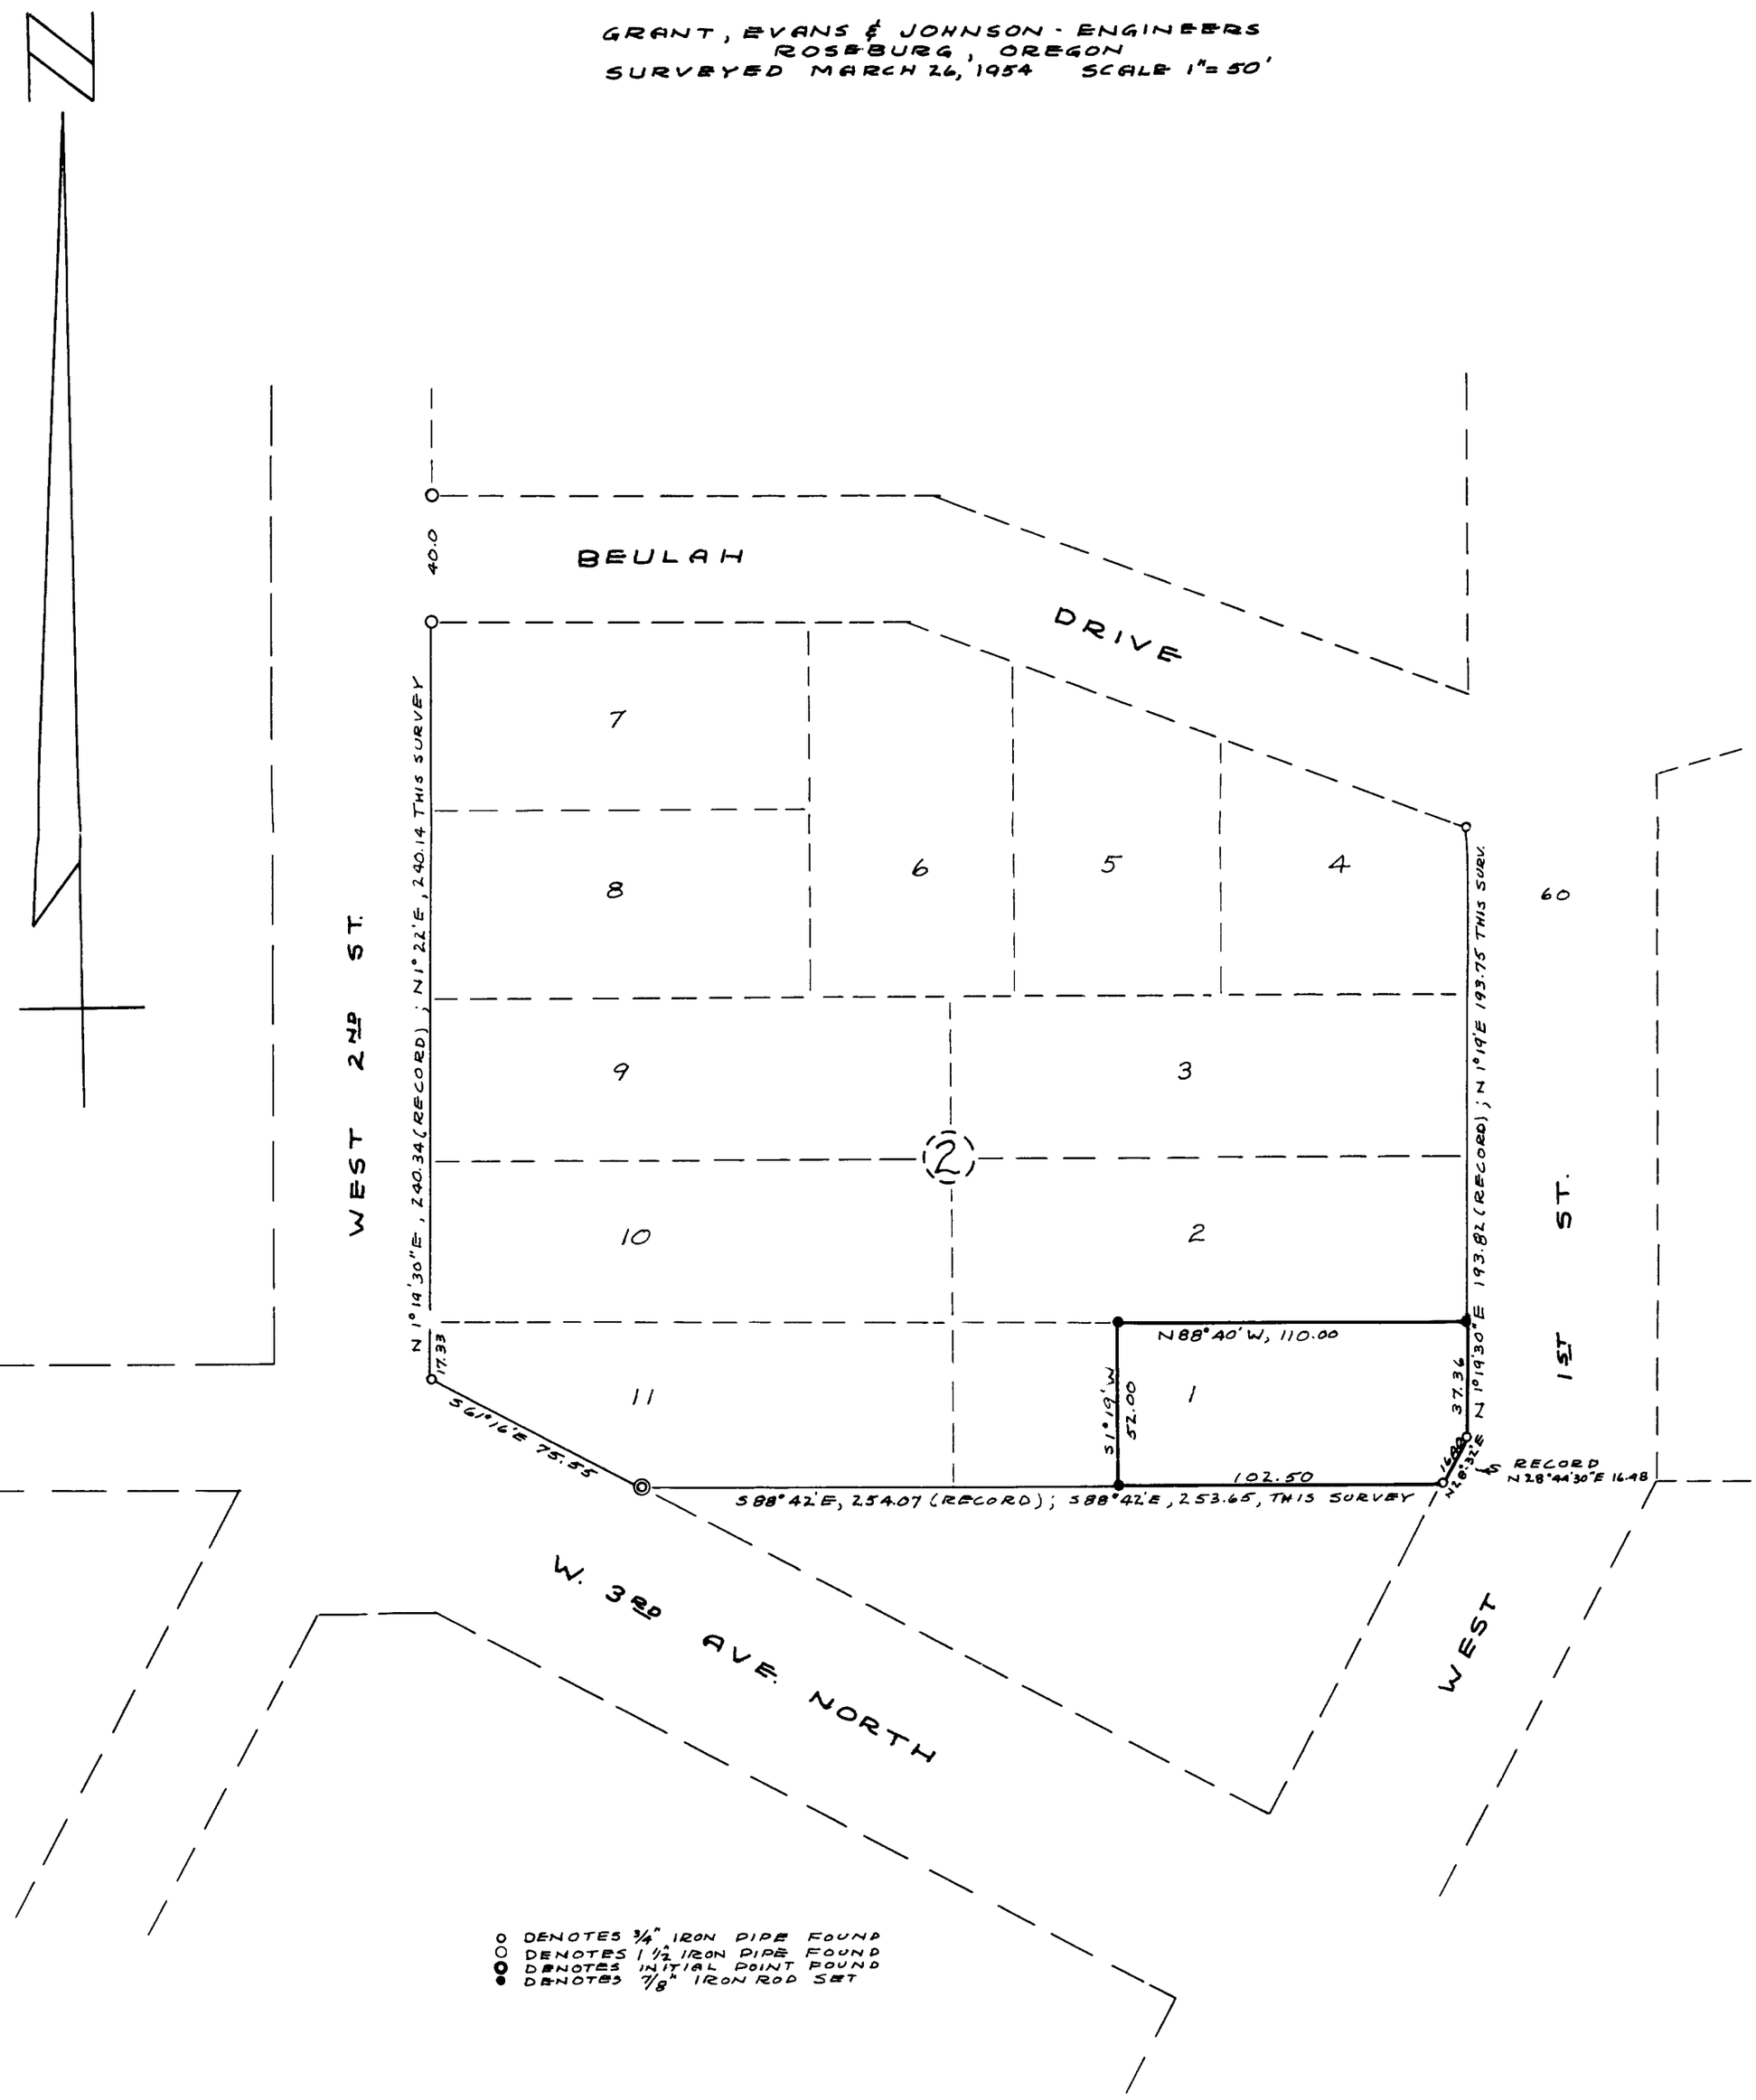

Lina E. Johnson