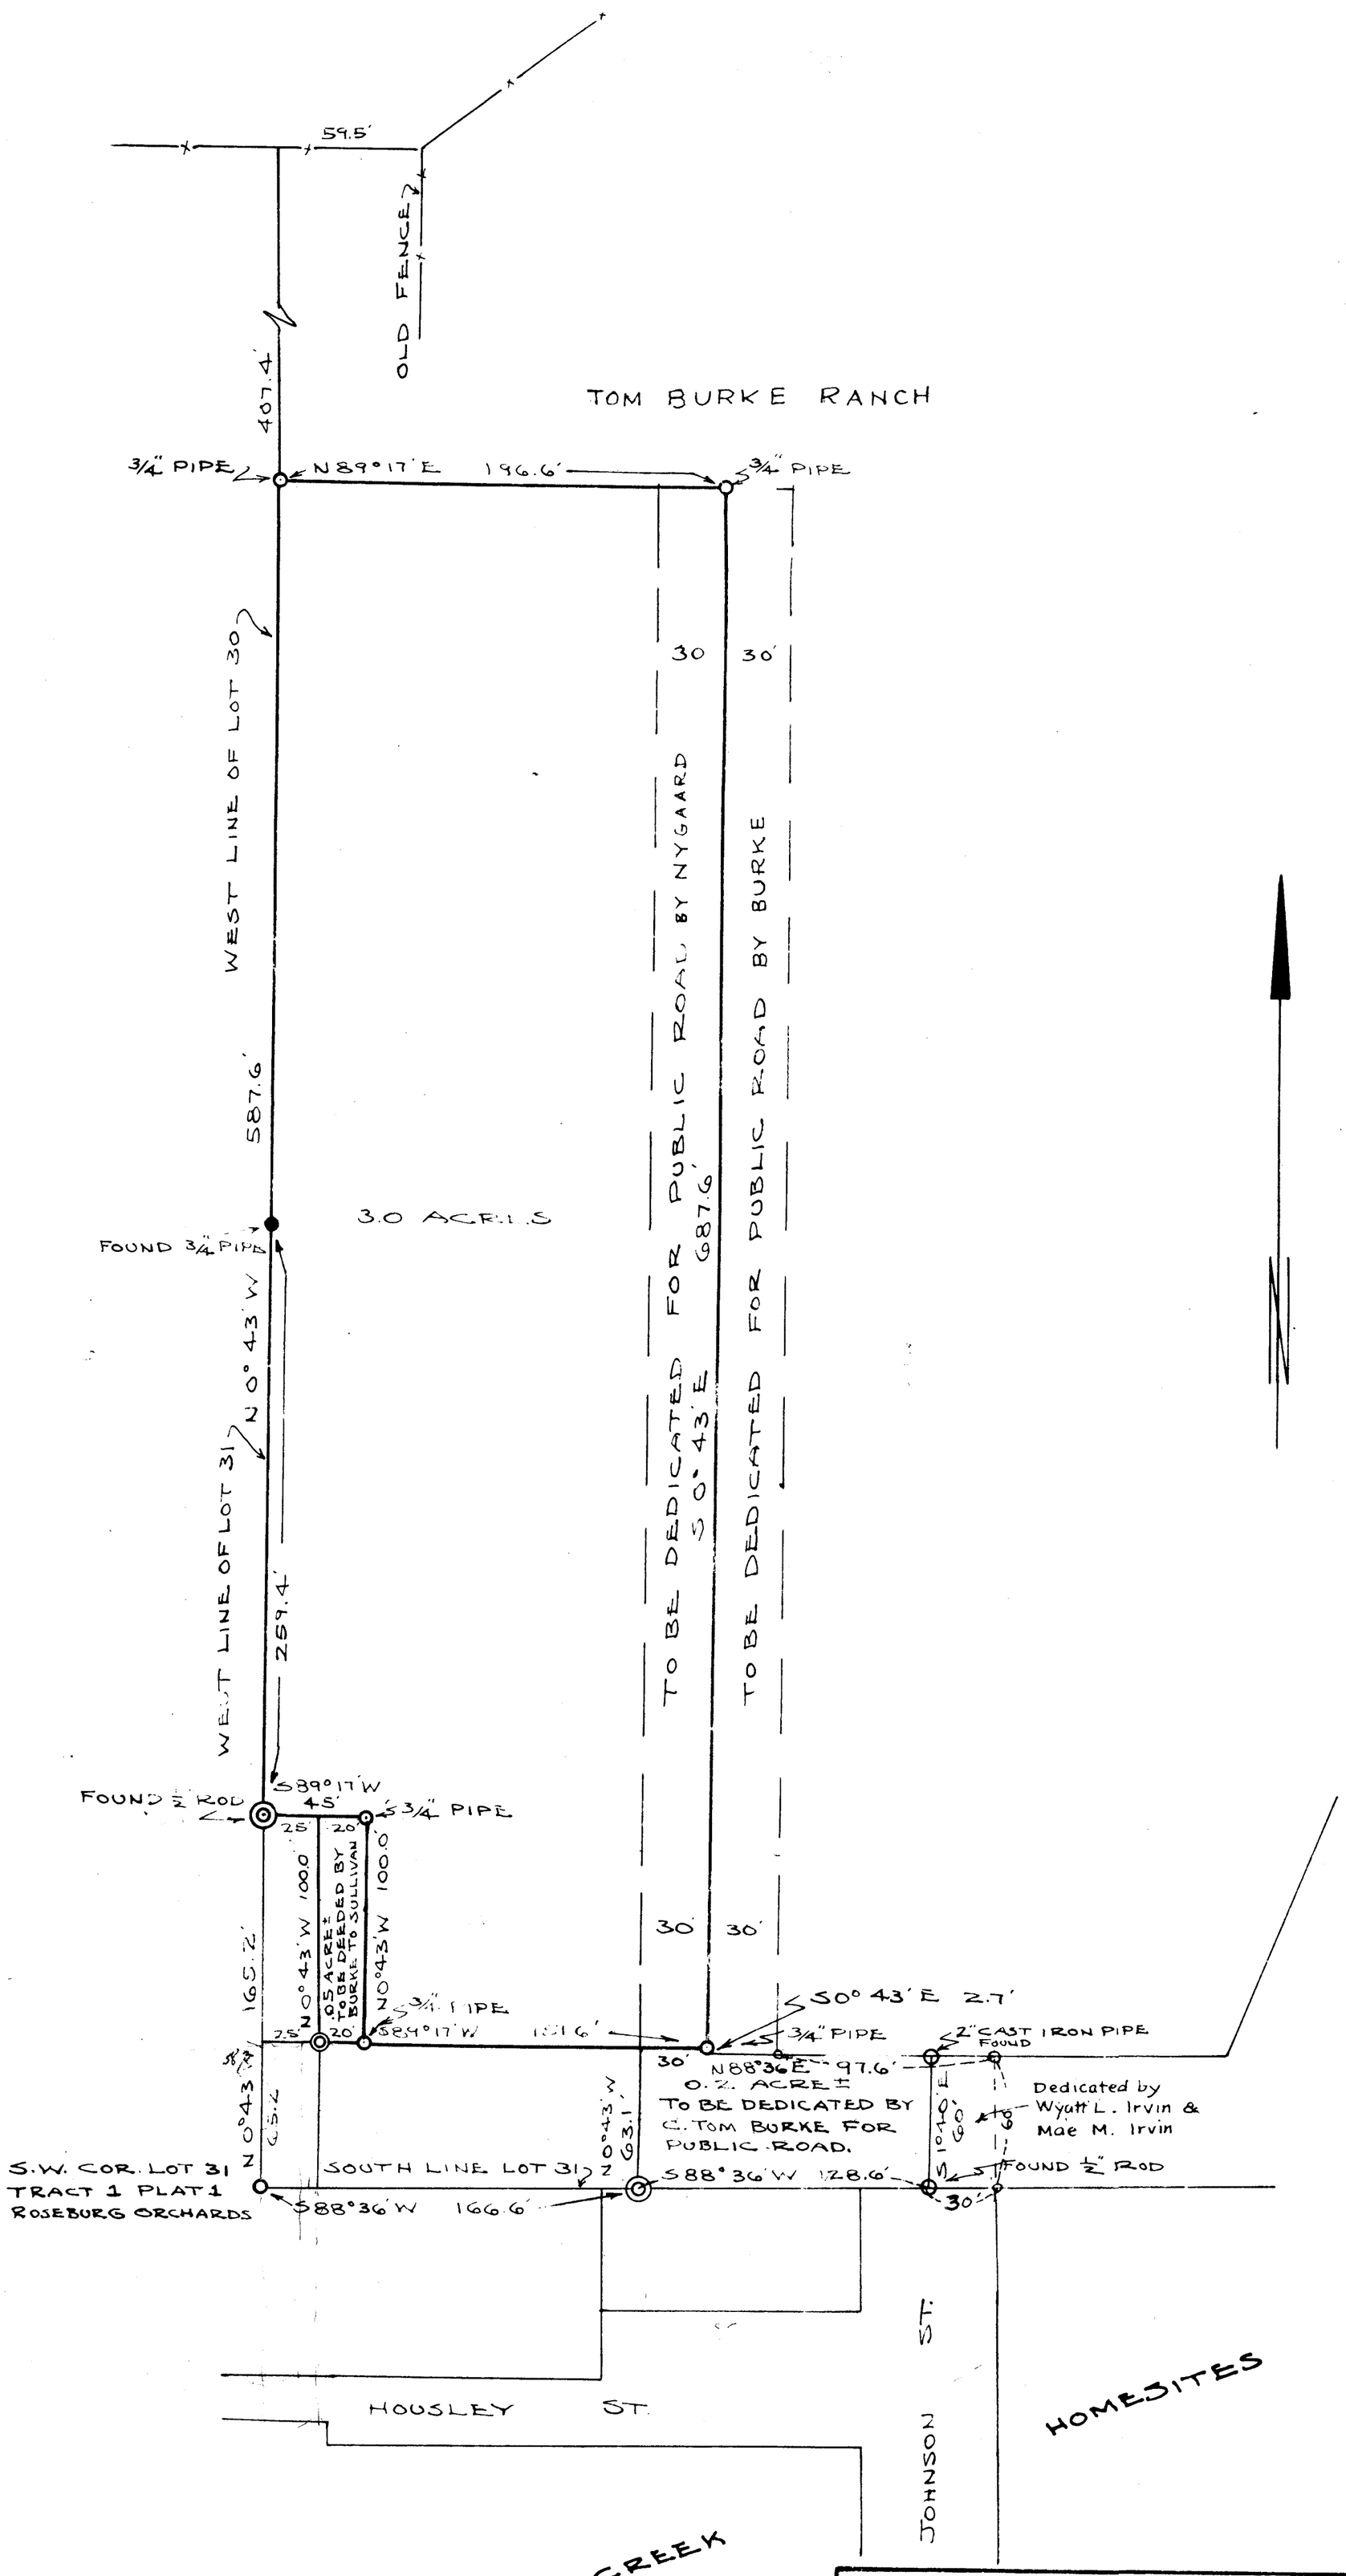

C. TOM BURKE PROPERTY
IN LOTS 31 & 30 OF TRACT 1, PLAT 1
ROSEBURG ORCHARDS CO.
DOUGLAS COUNTY, OREGON
MAR. 1953 – ARTHUR BOYER, ENGR. – SCALE 1" = 50'

COUNTY SURVEYORS FILE DATA
DO NOT REMOVE FROM OFFICE

COUNTY SURVEYORS FILE DATA
DO NOT REMOVE FROM OFFICE