COUNTY SURVEYORS FILE DATA
DO NOT REMOVE FROM OFFICE

SURVEY for THE PACIFIC TELEPHONE AND TELEGRAPH COMPANY

IN SECTIONS 17, 18, 19, 30, 31, 32

TWP. 23 SOUTH RANGE 3 W.W.M.

SCALE: 1"=200.0' AUGUST 1954

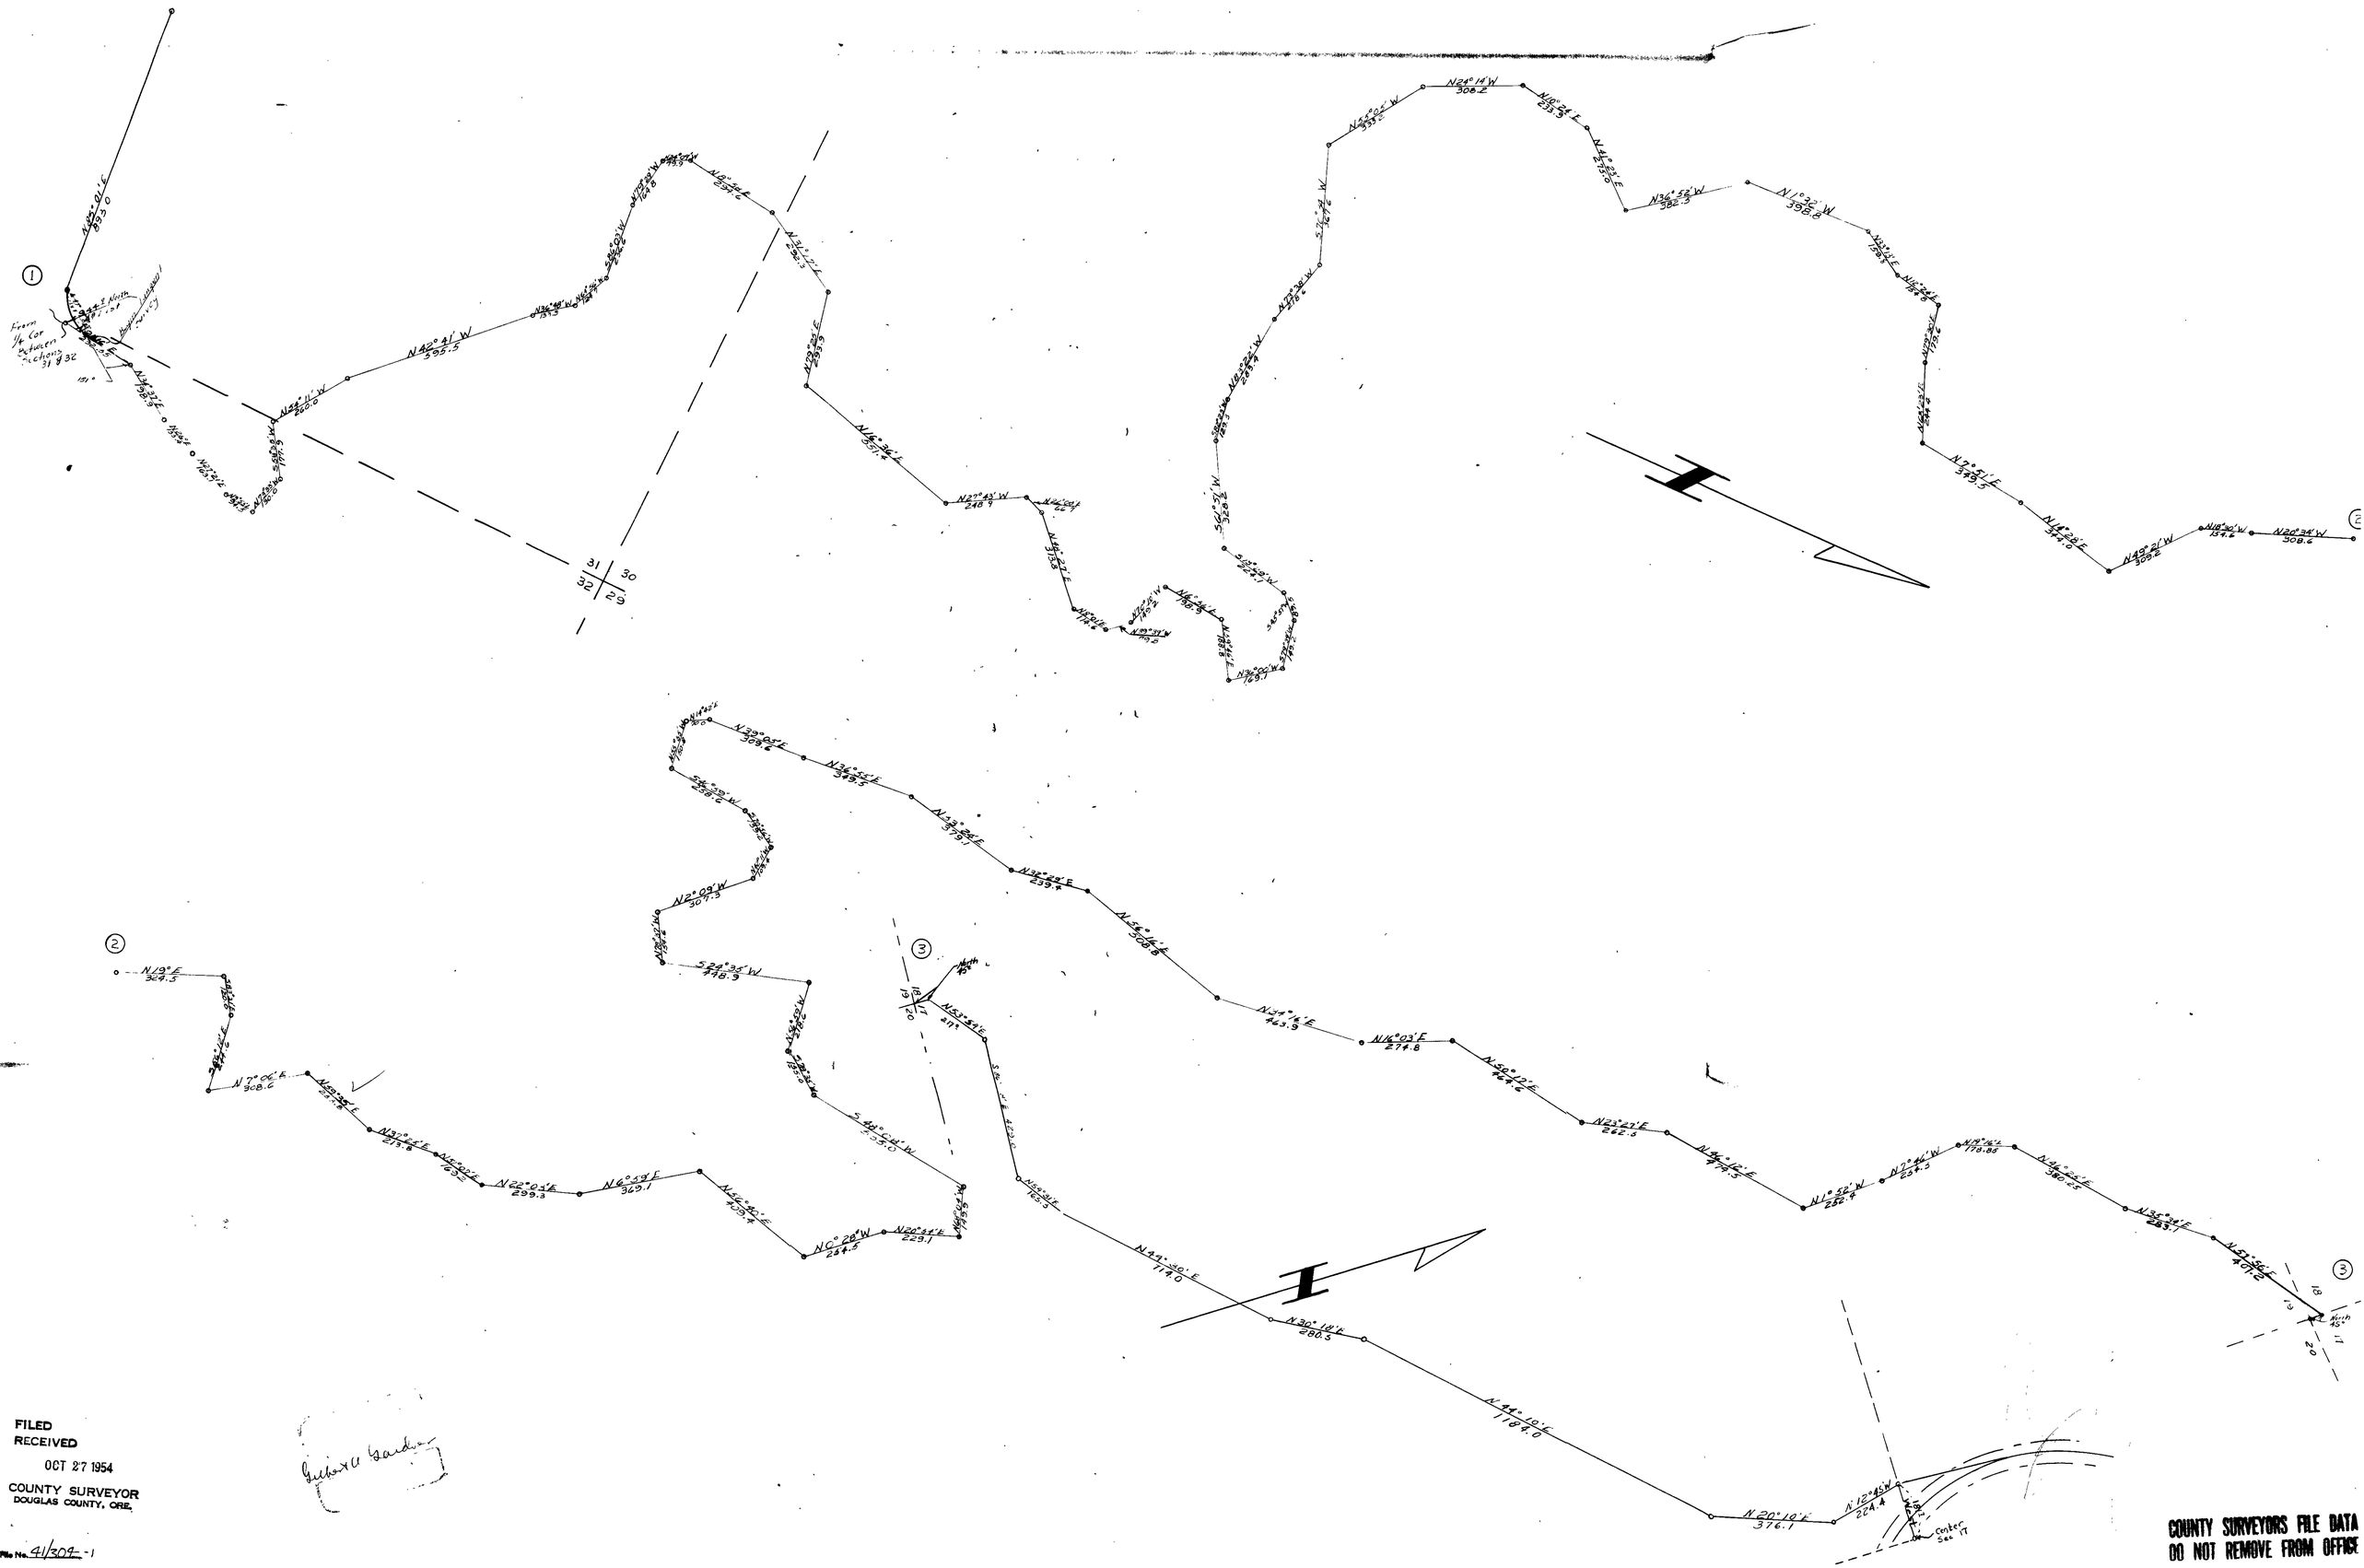

FILED
RECEIVED
OCT 27 1954
COUNTY SURVEYOR
DOUGLAS COUNTY, ORE.

Gilbert U Gardner

S. File No. 41/304-1

COUNTY SURVEYORS FILE DATA
DO NOT REMOVE FROM OFFICE