PARCELS IN LOT 55 · PLAT "H" · ROSEBURG HOME ORCHARD TRACTS · DOUGLAS COUNTY · OREGON

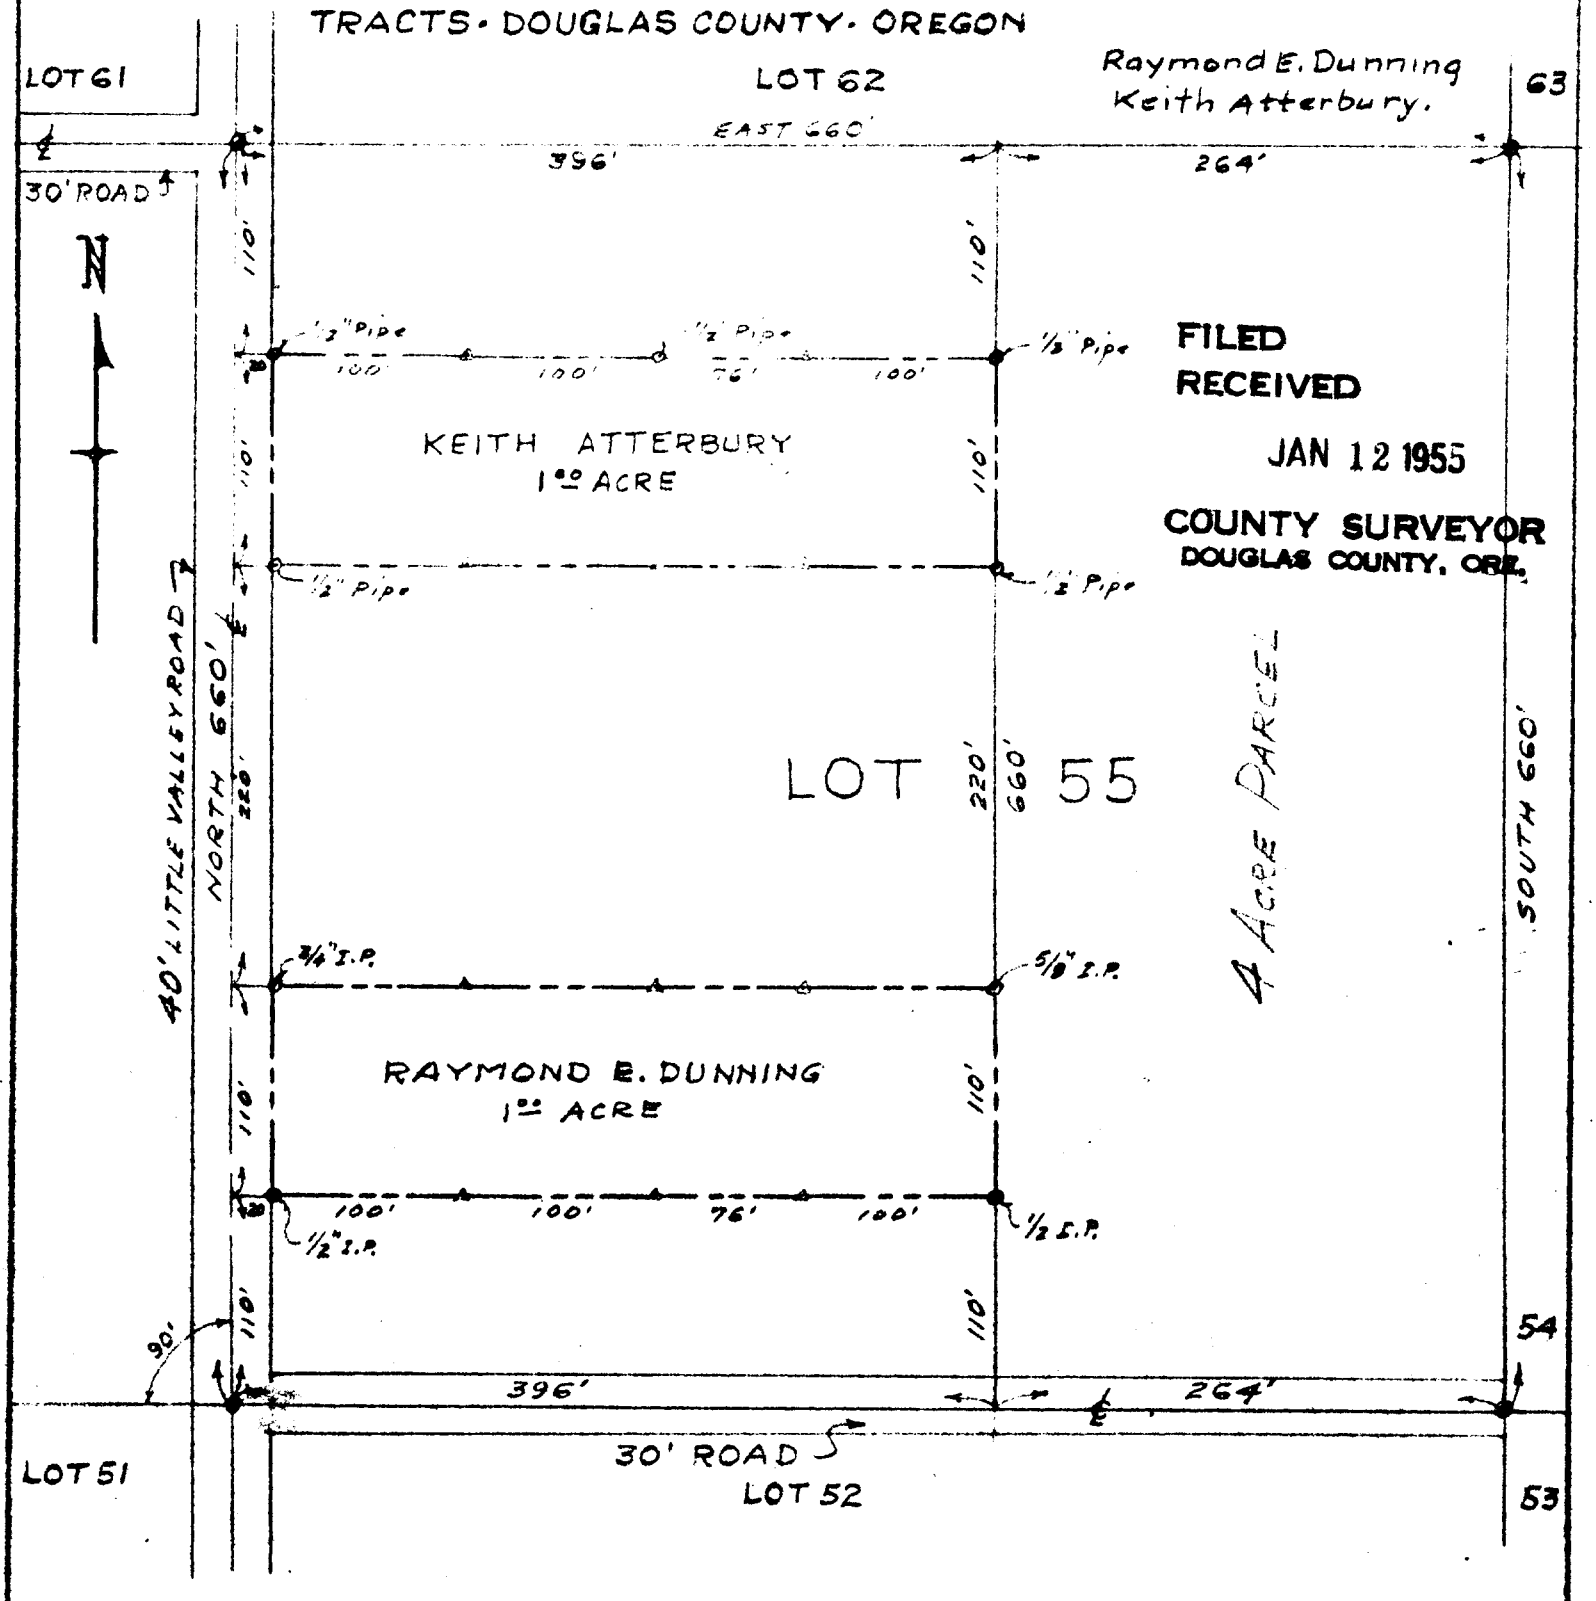

SURVEYED & PLATTED BY

SCALE 1" = 100'

JAMES R. DAUGHERTY

CIVIL-SANITARY ENGINEER

ROSEBURG · ORE.

JAN. 1955.

REGISTERED PROFESSIONAL ENGINEER 2339 James R. Daugherty OREGON NOV. 19, 1954 JAMES R. DAUGHERTY

C. S. File No. 41/328-1

COUNTY SURVEYORS FILE DATA
DO NOT REMOVE FROM OFFICE

T28 S, R6 W, Sec 3.