

PARCELS IN LOT 55 - PLAT "H" - ROSEBURG HOME ORCHARD TRACTS - DOUGLAS COUNTY - OREGON

LOT 61

LOT 62

Raymond E. Dunning
Keith Atterbury,
Marion A. Patrick

63

30' ROAD

N

396'

EAST 660'

264'

110'

110'

1/2" Pipe
100'

1/2" Pipe
76'

1/2" Pipe
100'

KEITH ATTERBURY
1⁰⁰ ACRE

110'

1/2" Pipe

1/2" Pipe

FILED
COUNTY SURVEYOR
DOUGLAS COUNTY, OREGON
4 ACRE PARCEL RECEIVED

LOT 56

LOT 55

40' LITTLE VALLEY ROAD

NORTH 660'

280'

220'

660'

SOUTH 660'

3/4" I.P.

5/8" I.P.

RAYMOND E. DUNNING
1⁰⁰ ACRE

110'

1/2" I.P.
100'

100'

76'

100'

1/2" I.P.

MARION A. PATRICK

110'

90'

1/2" I.P.

376'

1/2" I.P.

264'

30' ROAD

LOT 51

LOT 52

54


SURVEYED & PLATTED BY

SCALE 1" = 100'

JAMES R. DAUGHERTY

CIVIL-SANITARY ENGINEER

ROSEBURG, ORE.

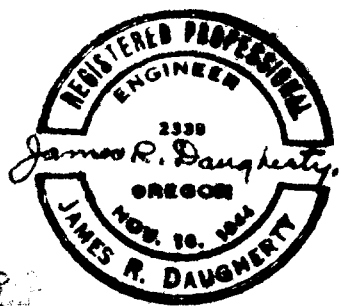

COUNTY SURVEYOR'S FILE MAIL
DO NOT REMOVE FROM OFFICE

JAN. 1955,
FEB. 18, 1956.

FILE NO. 41/328