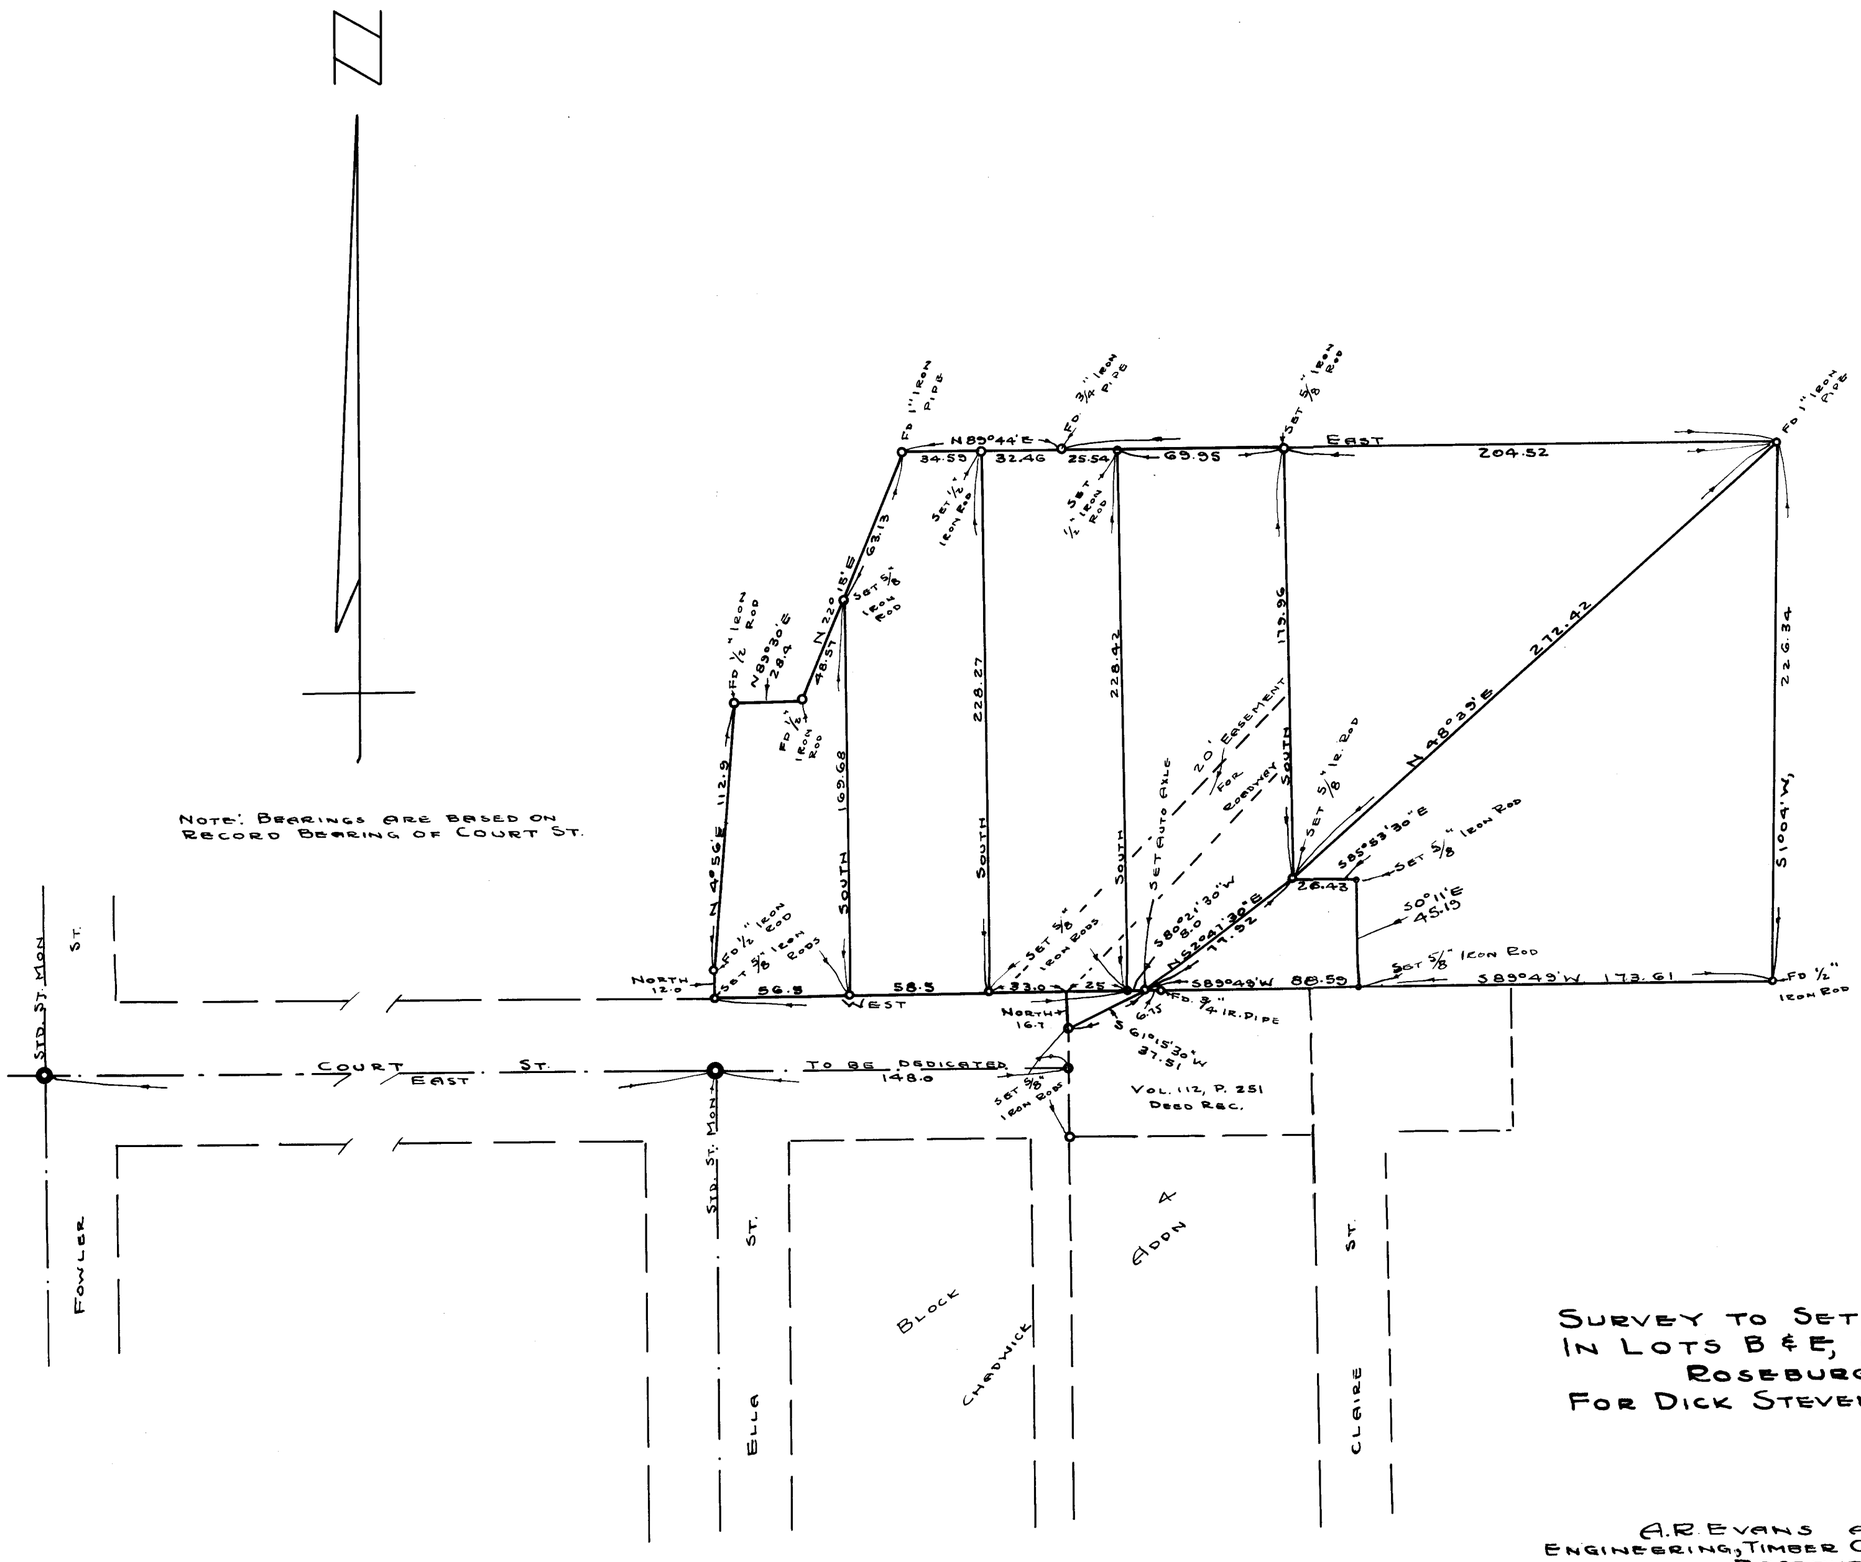

SURVEY TO SET PROPERTY CORNERS
IN LOTS B & E, CHADWICK ADDITION
ROSEBURG, OREGON
FOR DICK STEVENSON & CRAIG SHORT

A.R. EVANS AND ASSOCIATES
ENGINEERING, TIMBER CRUISING, AND SURVEYING
ROSEBURG, OREGON
SCALE OF MAP — 1" = 50'

REGISTERED PROFESSIONAL ENGINEER
A R Evans
NOV. 9, 1955
ARTHUR R. EVANS

FILED
RECEIVED
1955
SURVEYOR
COUNTY, ORE.

COUNTY SURVEYORS FILE DATA
DO NOT REMOVE FROM OFFICE

C.S. File No. 41/331

January-1955

1