NO. 1288
D-1

SURVEY FOR
CITY OF DRAIN
DOUGLAS COUNTY, OREGON

SECTION 17, T. 22 S. R. 5 WWM.

FILED

Date: MAY 16, 1955 By:
This survey consists of:
Map: CS 41/377
Narrative:
Corner Rpt:

DOUGLAS COUNTY SURVEYOR

THIS ORIGINAL SURVEY MAP WAS RECEIVED FROM THE MARION COUNTY SURVEYOR ON JULY 26, 1999 AND PUT INTO FOLDER WITH THE SEPIA COPY WHICH SHOWS THE ORIGINAL "FILED RECEIVED" STAMP BEARING THE FILE DATE MAY 16, 1955.

7-28-99 JP

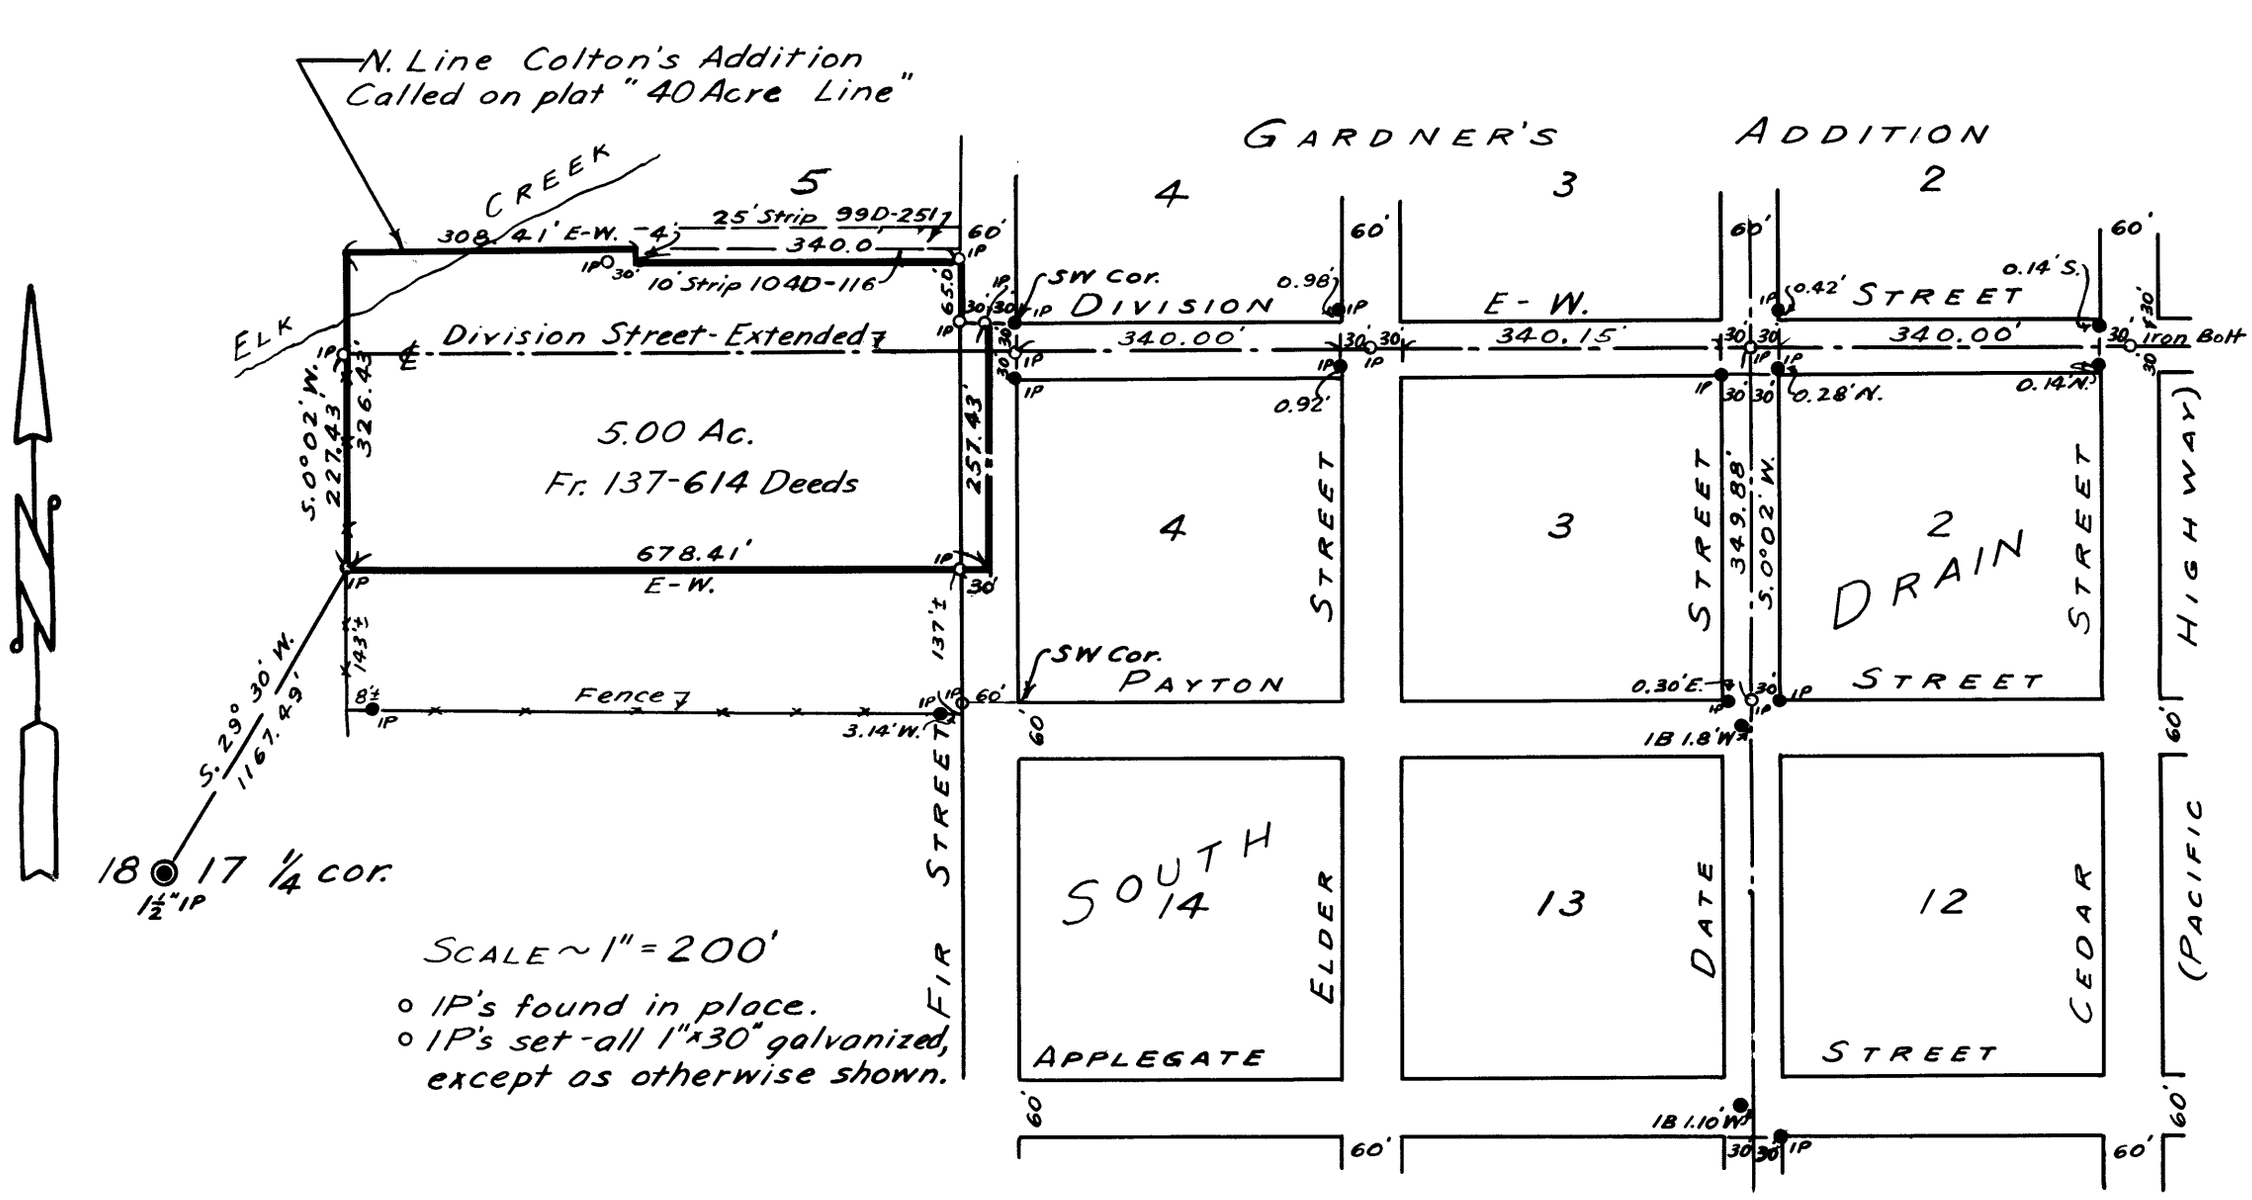

SCALE ~ 1" = 200'

- o IP's found in place.
- o IP's set - all 1" x 30" galvanized, except as otherwise shown.

NOTES:

1. Used as ℄ Division Street - Midpoint of IP's 60.00' apart on E. Line Fir Street, ℄ midpoint of IP's 59.72' apart on W. Line Cedar Street.
2. Used as ℄ Date Street - Midpoint of IP's 60.00' apart on S. Line Division Street ℄ point 30.00' W. of IP @ SE cor. Applegate ℄ Date Streets.
3. Dimensions of blocks in S. Drain - 320' N-S ; 340' E-W.
4. Exact agreement with record E-W on Blks. 2 ℄ 4, using IP's found in place.
5. Near agreement with record E-W. on Blk. 3 ℄ all blocks N-S.
6. No evidence of E. Line Micelli's Addition available on ground or from records.
7. Used existing fence as E. Line Micelli's Addition ℄ W. Line 5.00 Ac. tract.
8. Tie to 1/4 cor. between Sec. 17 ℄ 18 from SW cor. 5.00 acre tract is as shown.
9. Bearings not known to be true.
10. Portions or all of Micelli's Add., Colton's Add. ℄ Fir St. are vacated.

REGISTERED
OREGON
LAND SURVEYOR
David F. Bates
JULY 7, 1944
DAVID F. BATES
24

Surveyed - April 7, 8, 1955
David F. Bates
477 Court Street
Salem, Oregon

C.S. File No. 41/377