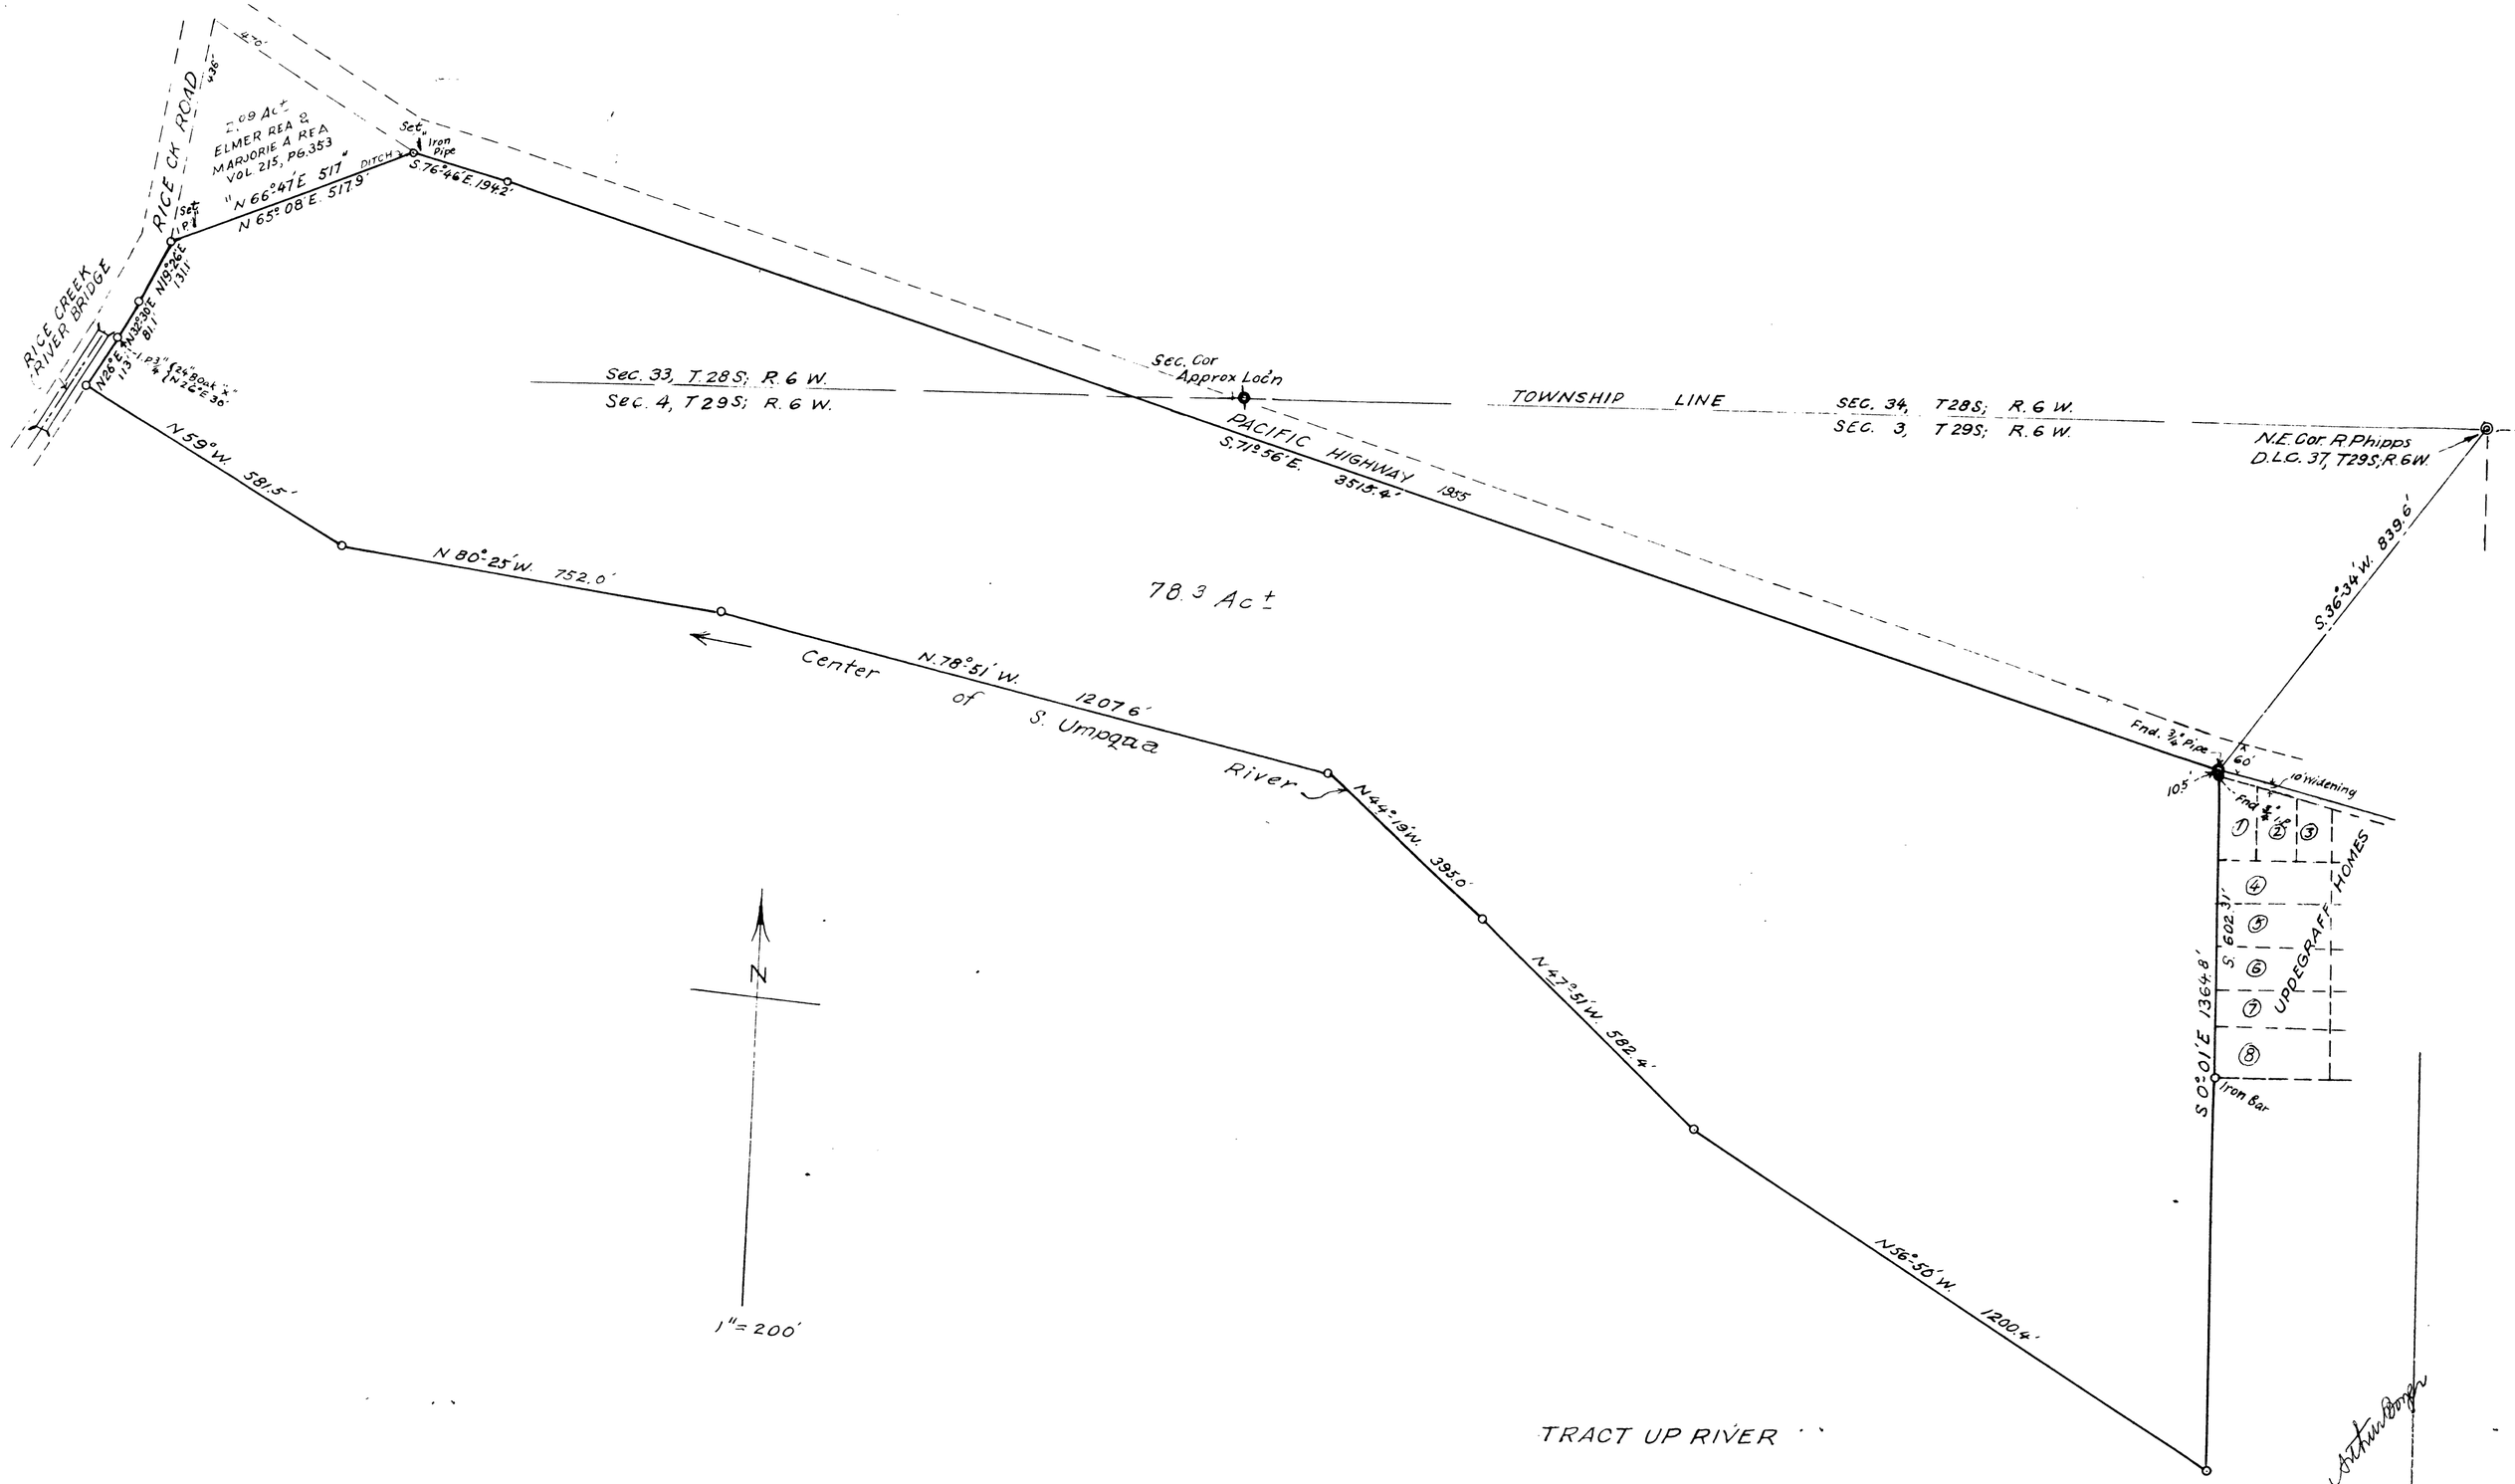

PORTION OF HELEN PHIPPS PROPERTY
BET. HIGHWAY & CEN S. UMPQUA RIVER & BET. RICE CREEK RIVER BRIDGE & UPDEGRAFF HOMES IN THE ROBT. PHIPPS D.L.C. #37, IN SEC'S 33 & 34, T.28S; R.6W. & SEC'S 3 & 4, T.29S; R.6W; W.M; DOUGLAS COUNTY, ORE
MAR 1951 1953. 1" = 200'

FILED
RECEIVED
APR 28 1955
COUNTY SURVEYOR
DOUGLAS COUNTY, ORE.

COUNTY SURVEYOR FILE DATA
DO NOT REMOVE FROM OFFICE

C.S. File No. 41/383