COUNTY SURVEYORS FILE DATA
DO NOT REMOVE FROM OFFICE

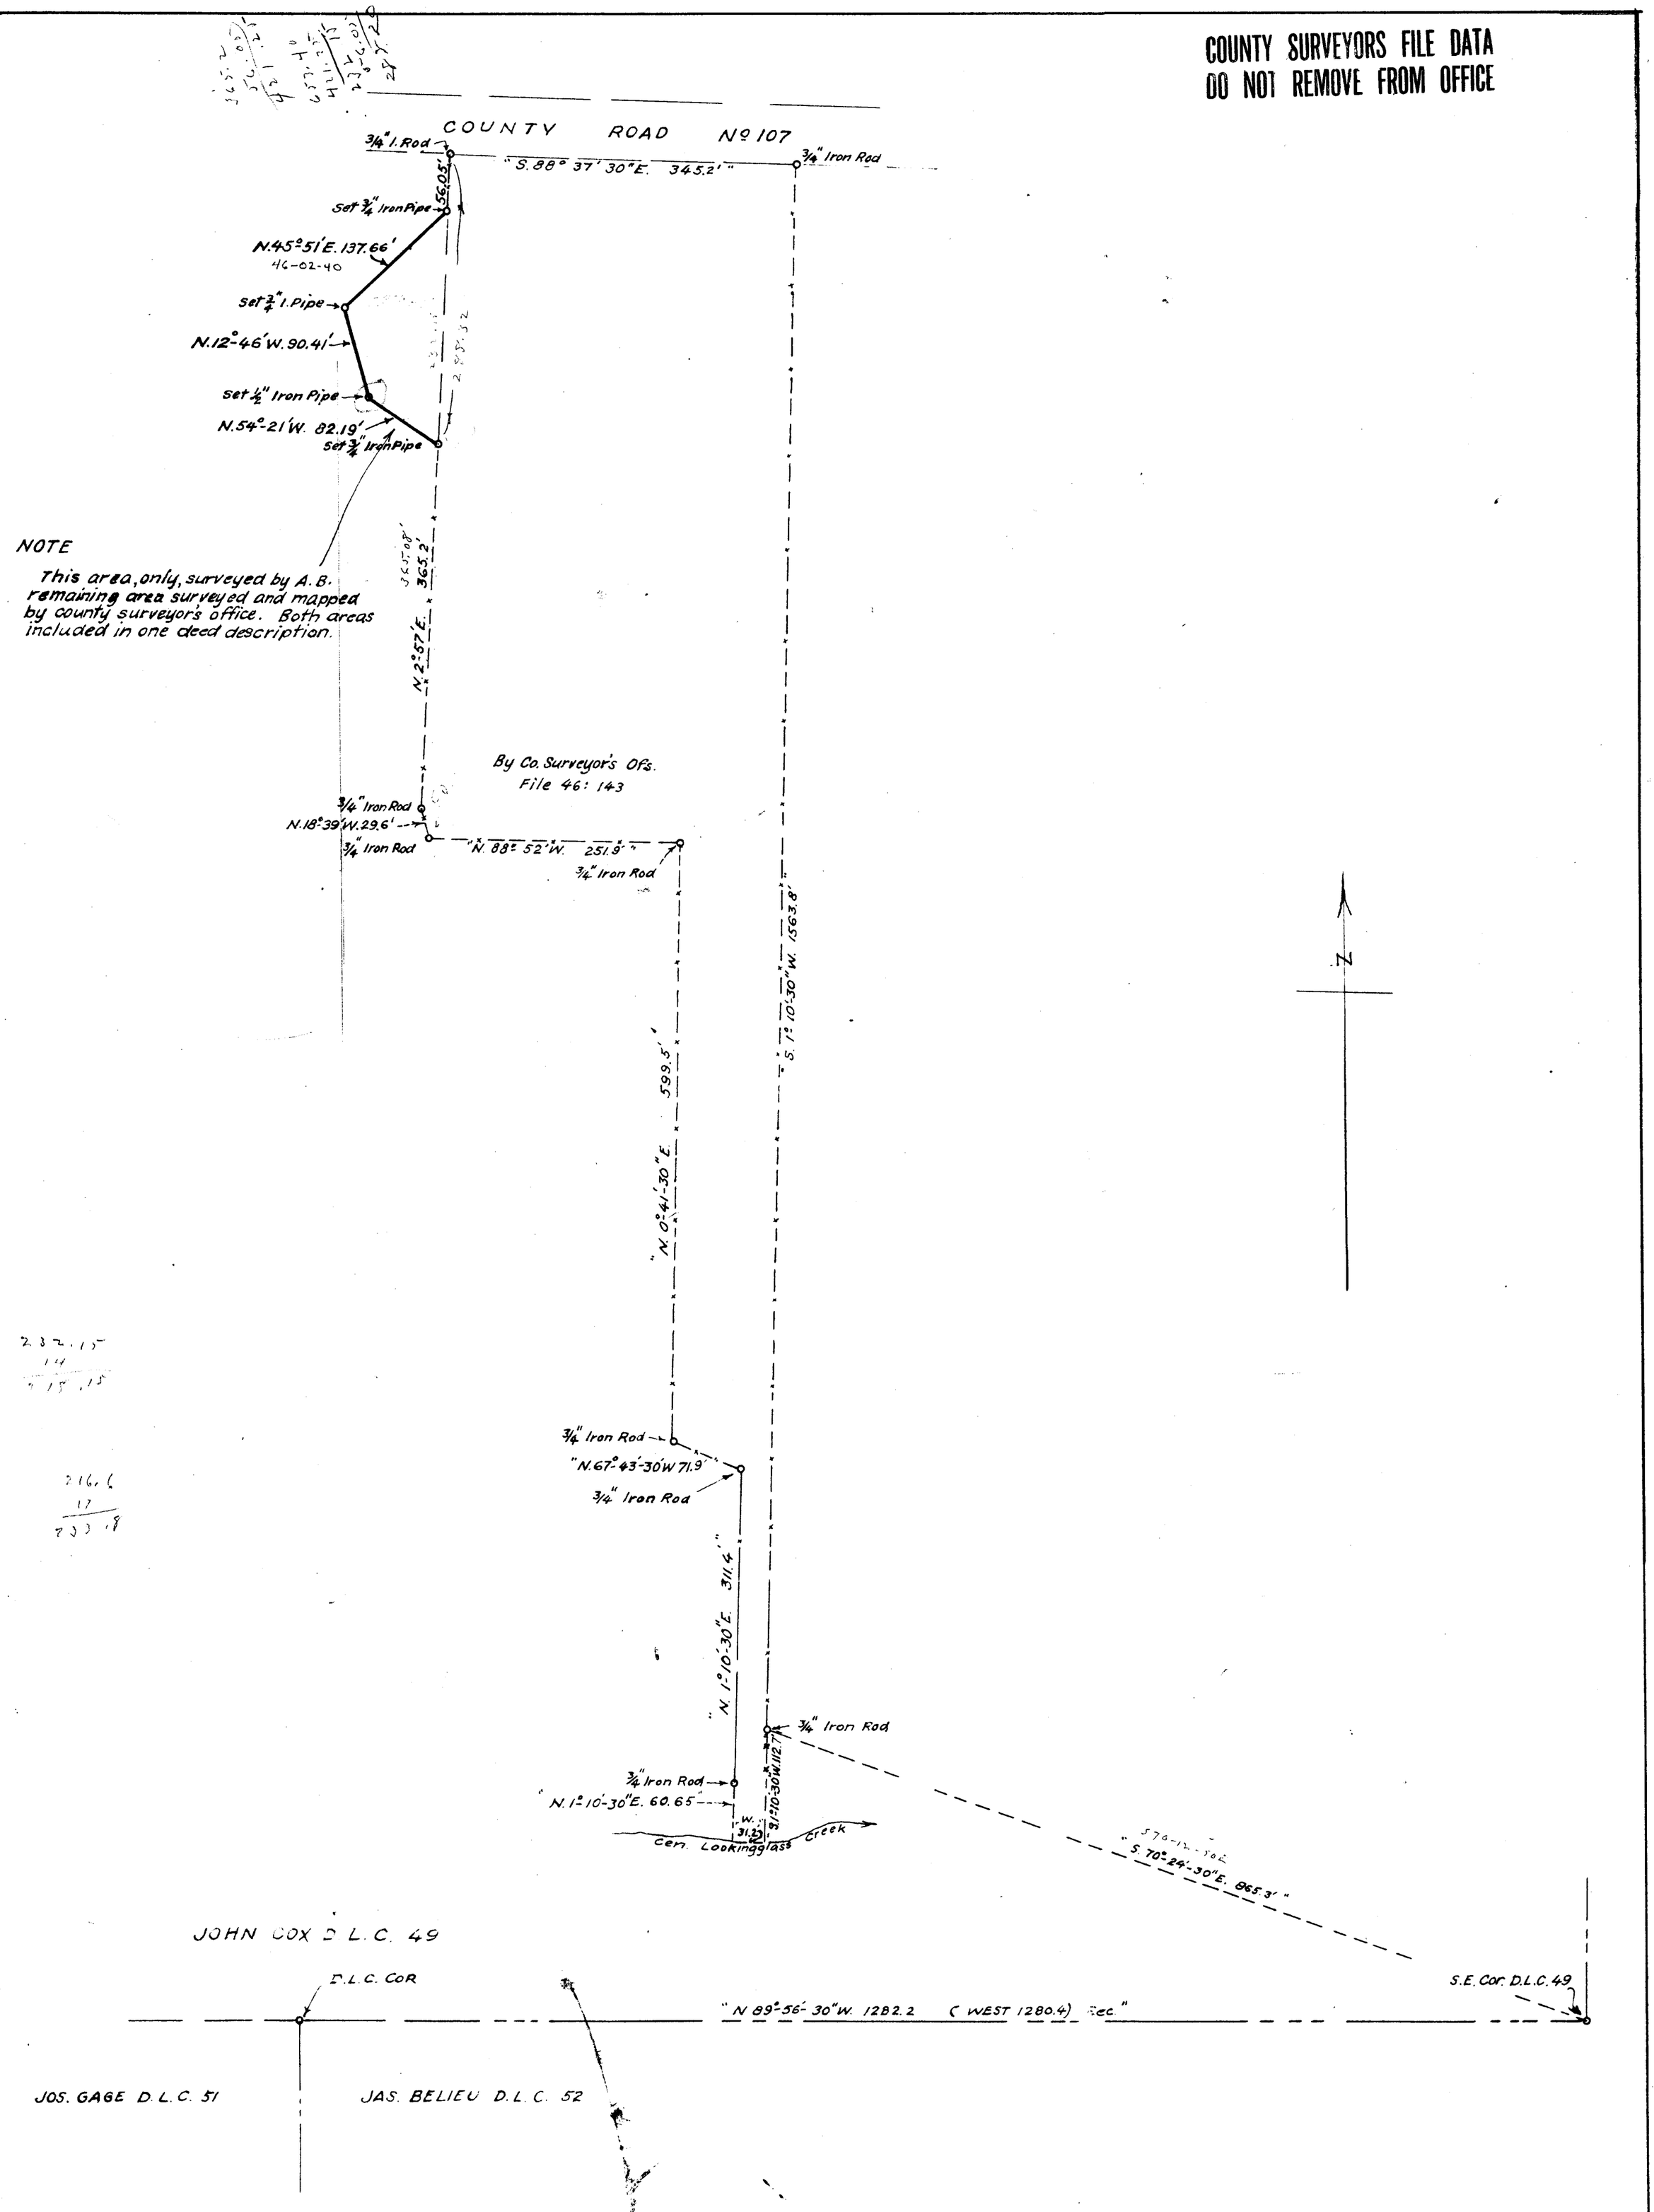

FILED
RECEIVED
AUG 22 1955
COUNTY SURVEYOR
DOUGLAS COUNTY, ORE.

Note: "Bearings are true, Based on data shown on map of State Highway No. 42."

SHERMAN McBEE, BROCKWAY, ORE.
PORTION OF SEC. 20, T.28S; R.6W; WIL. MER.
COPIED FROM SURVEY BY COUNTY SURVEYOR'S OFFICE OF JUNE 11, 1955, EXCEPT FOR ADDITIONAL AREA, AS SHOWN, WHICH WAS SURVEYED JULY 27, 1955 BY A. BOYER
SCALE, 1" = 100'

C. S. File No. 42/8