LOTS 13·14·15 & 16·BLOCK 1·WEST VIEW ADDITION & LOTS 1 & 2·BLOCK 12·TERRACE PARK ADDITION

CITY OF ROSEBURG·ORE.

Surveyed For
Fred Sohn

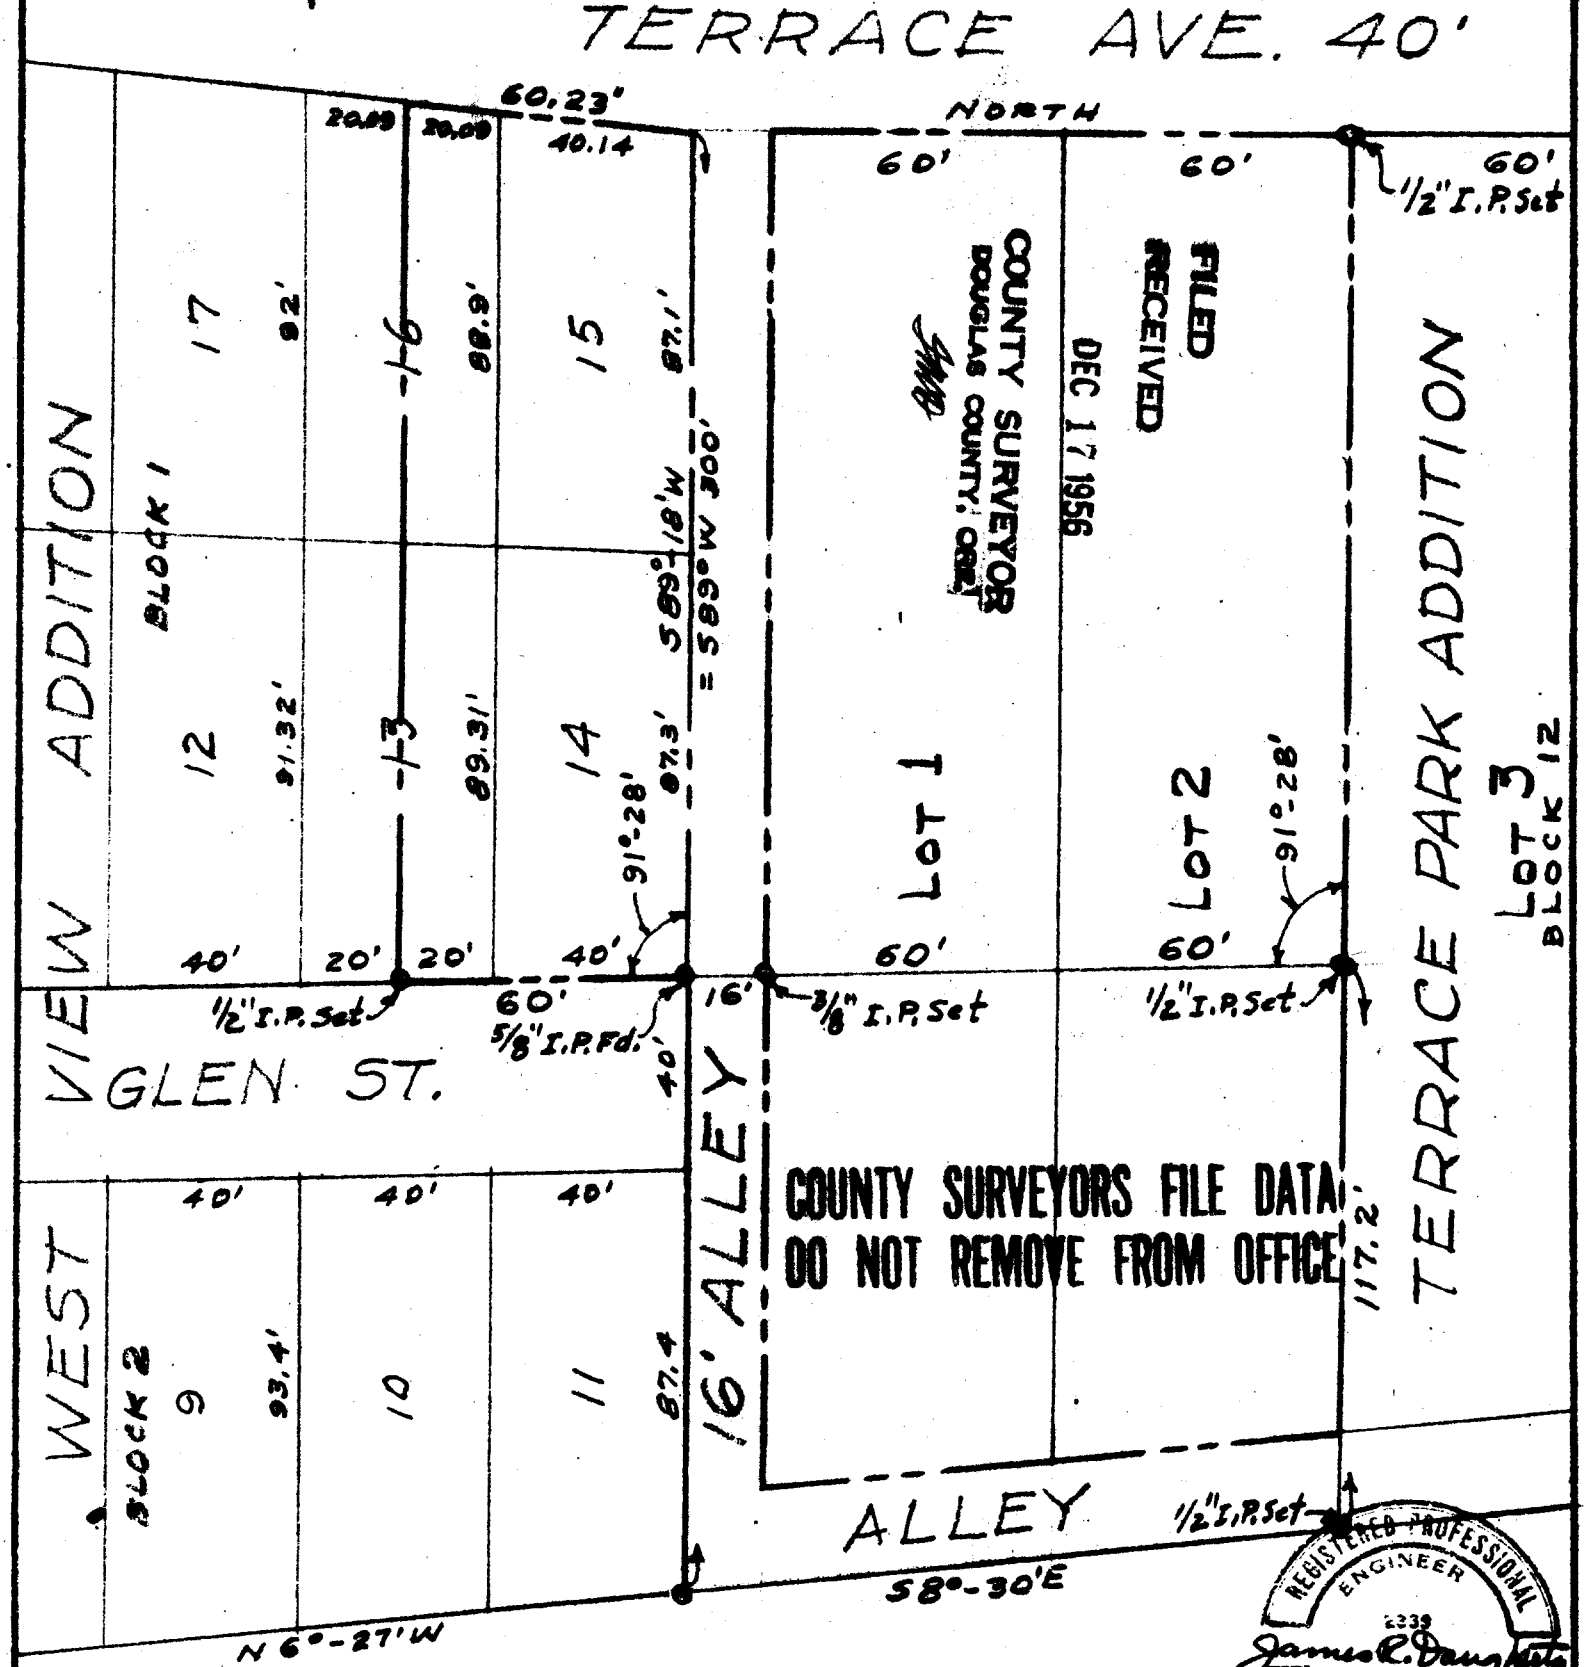

REGISTERED PROFESSIONAL ENGINEER 2239 James R. Daugherty OREGON NOV. 10, 1944 JAMES R. DAUGHERTY

SCALE 1" = 40'

Aug. 7, 1956.

JAMES R. DAUGHERTY
CIVIL-SANITARY ENGINEER
ROSEBURG·ORE

C.S. File No. 42/204

Sec 19, T27S, R5W.