TWP. 29 S. R. 4 W.W.M.

COUNTY SURVEYOR'S FILE DATA
DO NOT REMOVE FROM OFFICE

GRATZ SURVEY

SECTIONS 6, 7 + 8 TWP. 29 S. R 4 W W M
SURVEYED + PLATTED BY
JAMES R. DAUGHERTY
CIVIL - SANITARY ENGINEER
214 US. BANK BLDG. ROSEBURG ORE.

Sheet # 1 of 2
June 1949

VAR. 20°30'
ALL COR. MARKED WITH STAKES AND IRON PINS

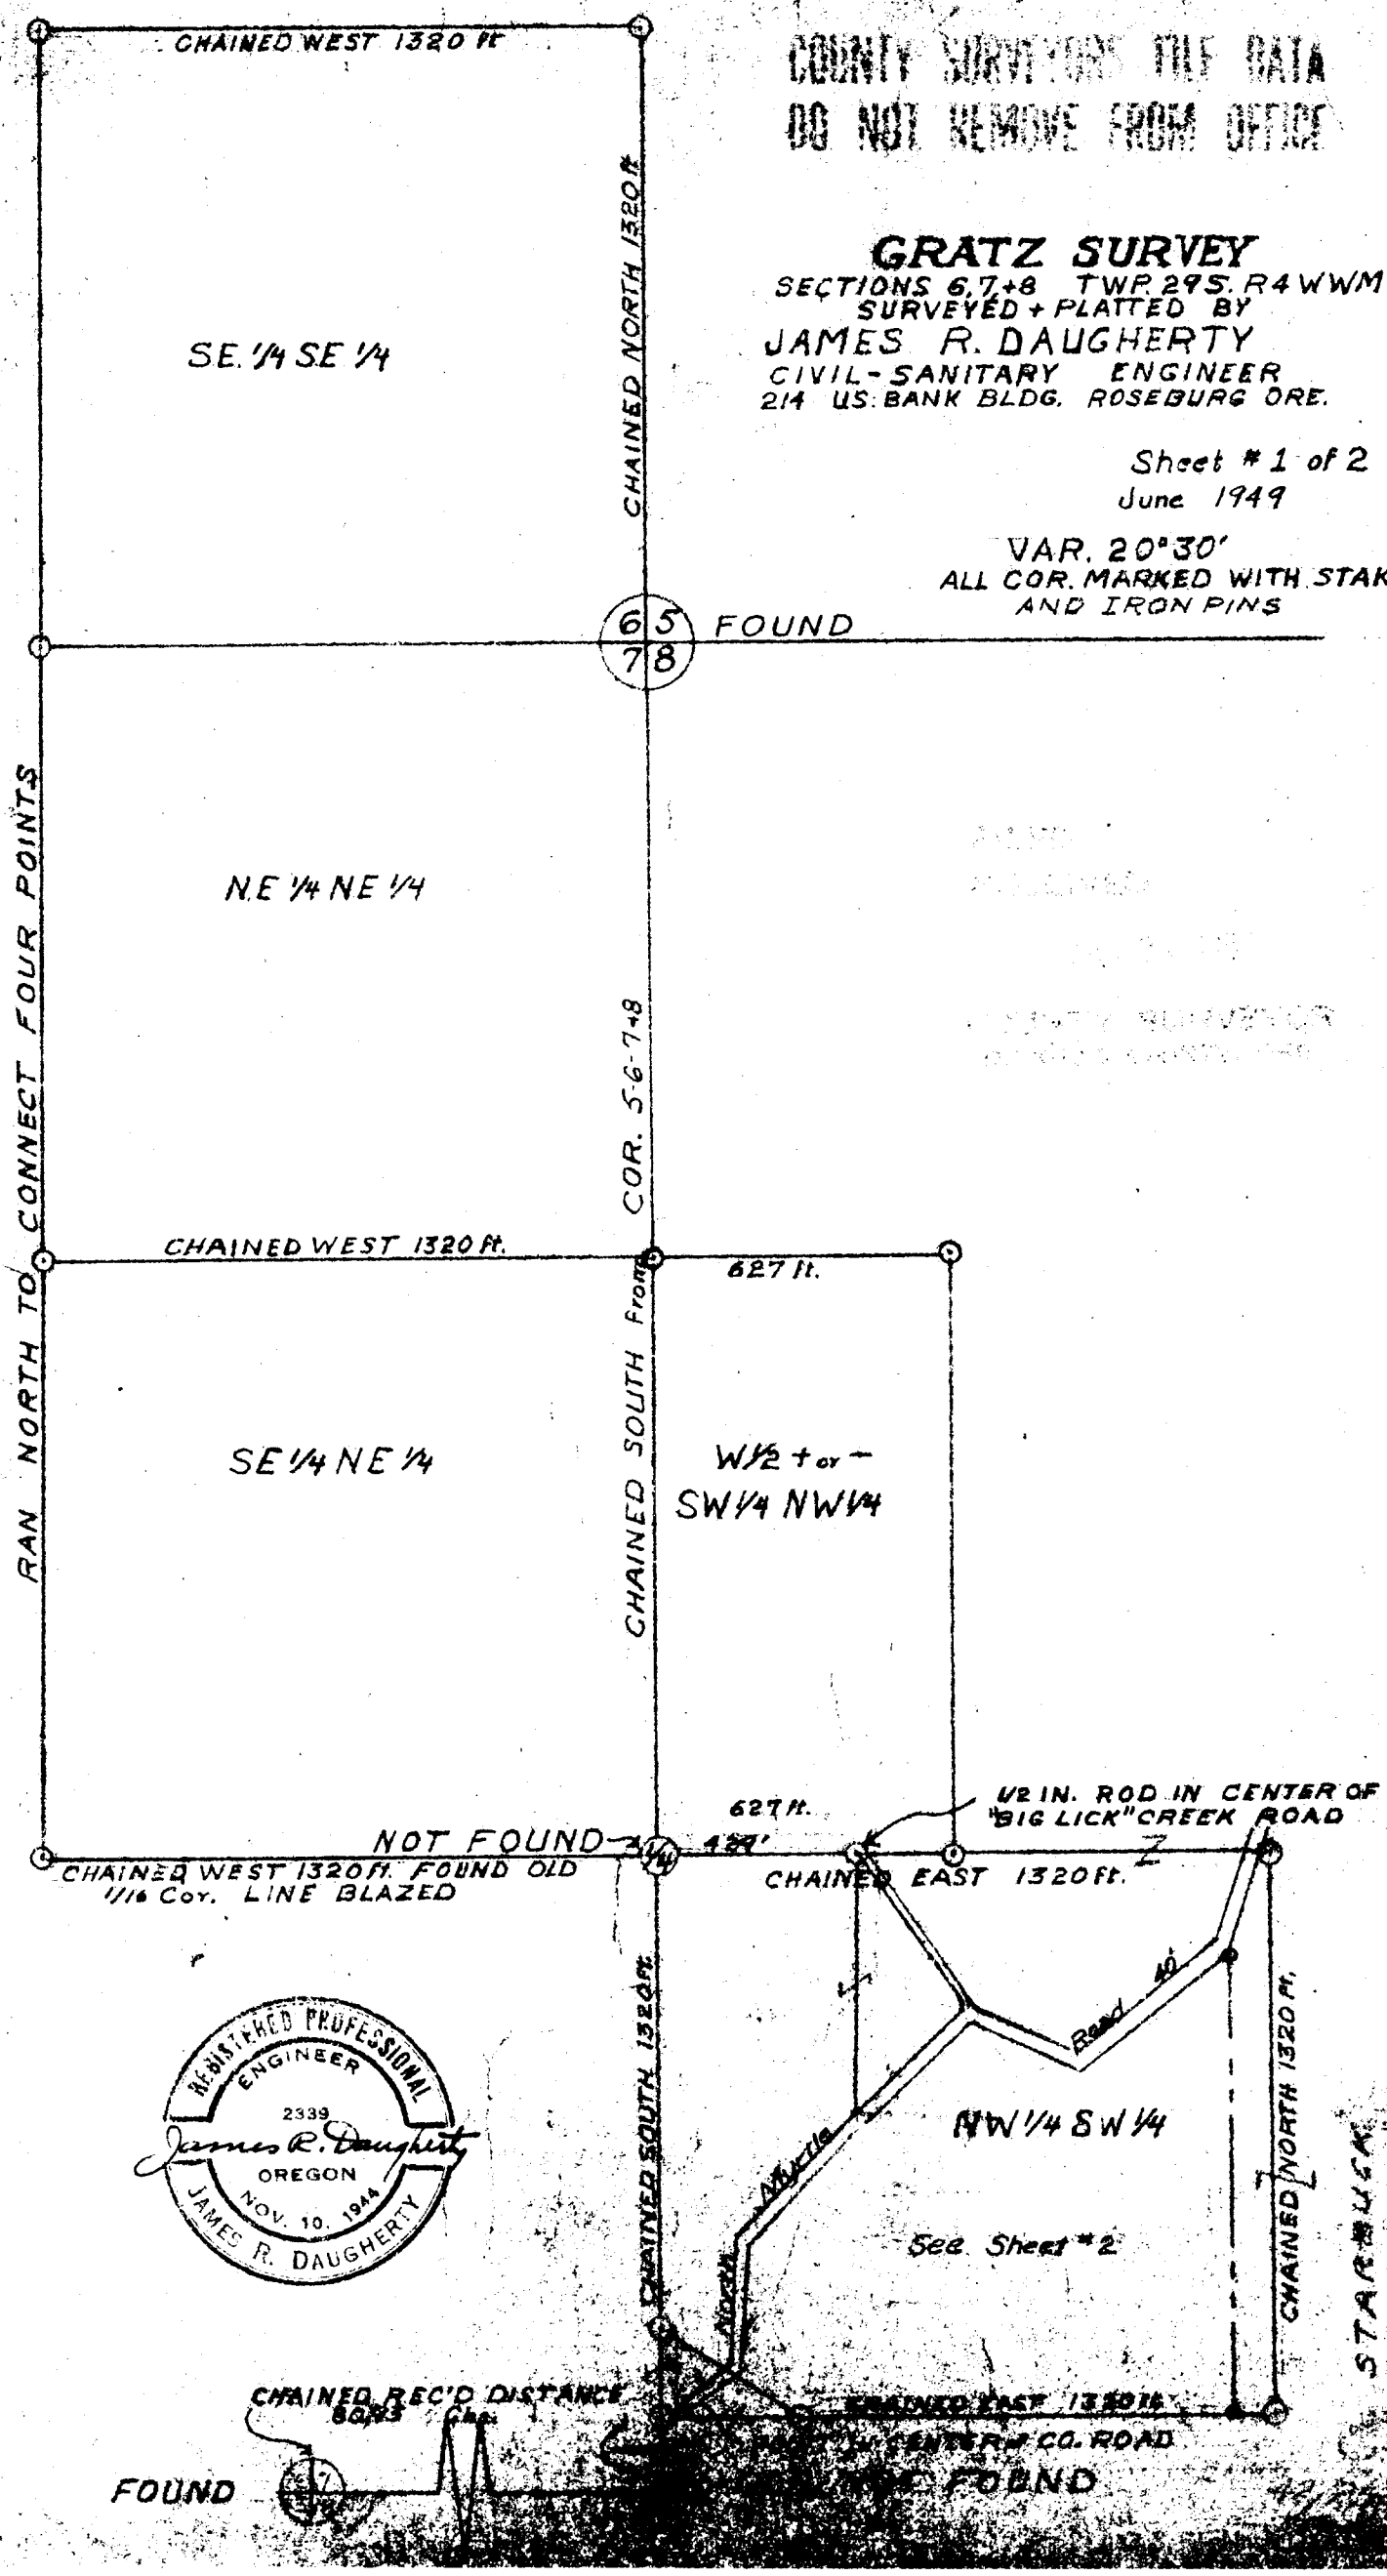

REGISTERED PROFESSIONAL ENGINEER
2339
James R. Daugherty
OREGON
NOV. 10, 1944
JAMES R. DAUGHERTY