

*BME*  
COUNTY SURVEYOR  
DOUGLAS COUNTY, ORE.

JUN 19 1957

FILED  
RECEIVED

COUNTY SURVEYORS FILE DATA  
DO NOT REMOVE FROM OFFICE



Sec. 33  
Sec. 34

Found Truck Axle, plus 6" plate-cap

1/4 Cor. Common To

Sec. 33 AND 34  
T30S R6W WM

45.0 FT.

1240.2 FT.

COUNTY

S 75° 45' W  
313.6

ROAD

(GLENBROOK LOOP)

S 47° 15' W  
424.8

To RIDDLE

W. LINE OF  
W.L. WILSON D.L.C. #41

NORTH  
581.50


E. LINE OF  
JOHN CATCHING D.L.C. #40

4.7 ACRES

EAST  
548.0

S 17° 20' E  
226.0

*Donald R. Martin*

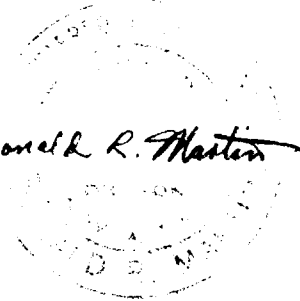

• SET 1/2" IRON RODS

SURVEY & PLAT PREPARED FOR  
HARRY DAYTON

RIDDLE, OREGON

SEC. 34 T30S R6W W.M. DOUGLAS COUNTY, OREGON

SCALE: 1" = 100'

C. S. File No. *42/268-1*

MAY 15, 1957

*Don R. Martin*