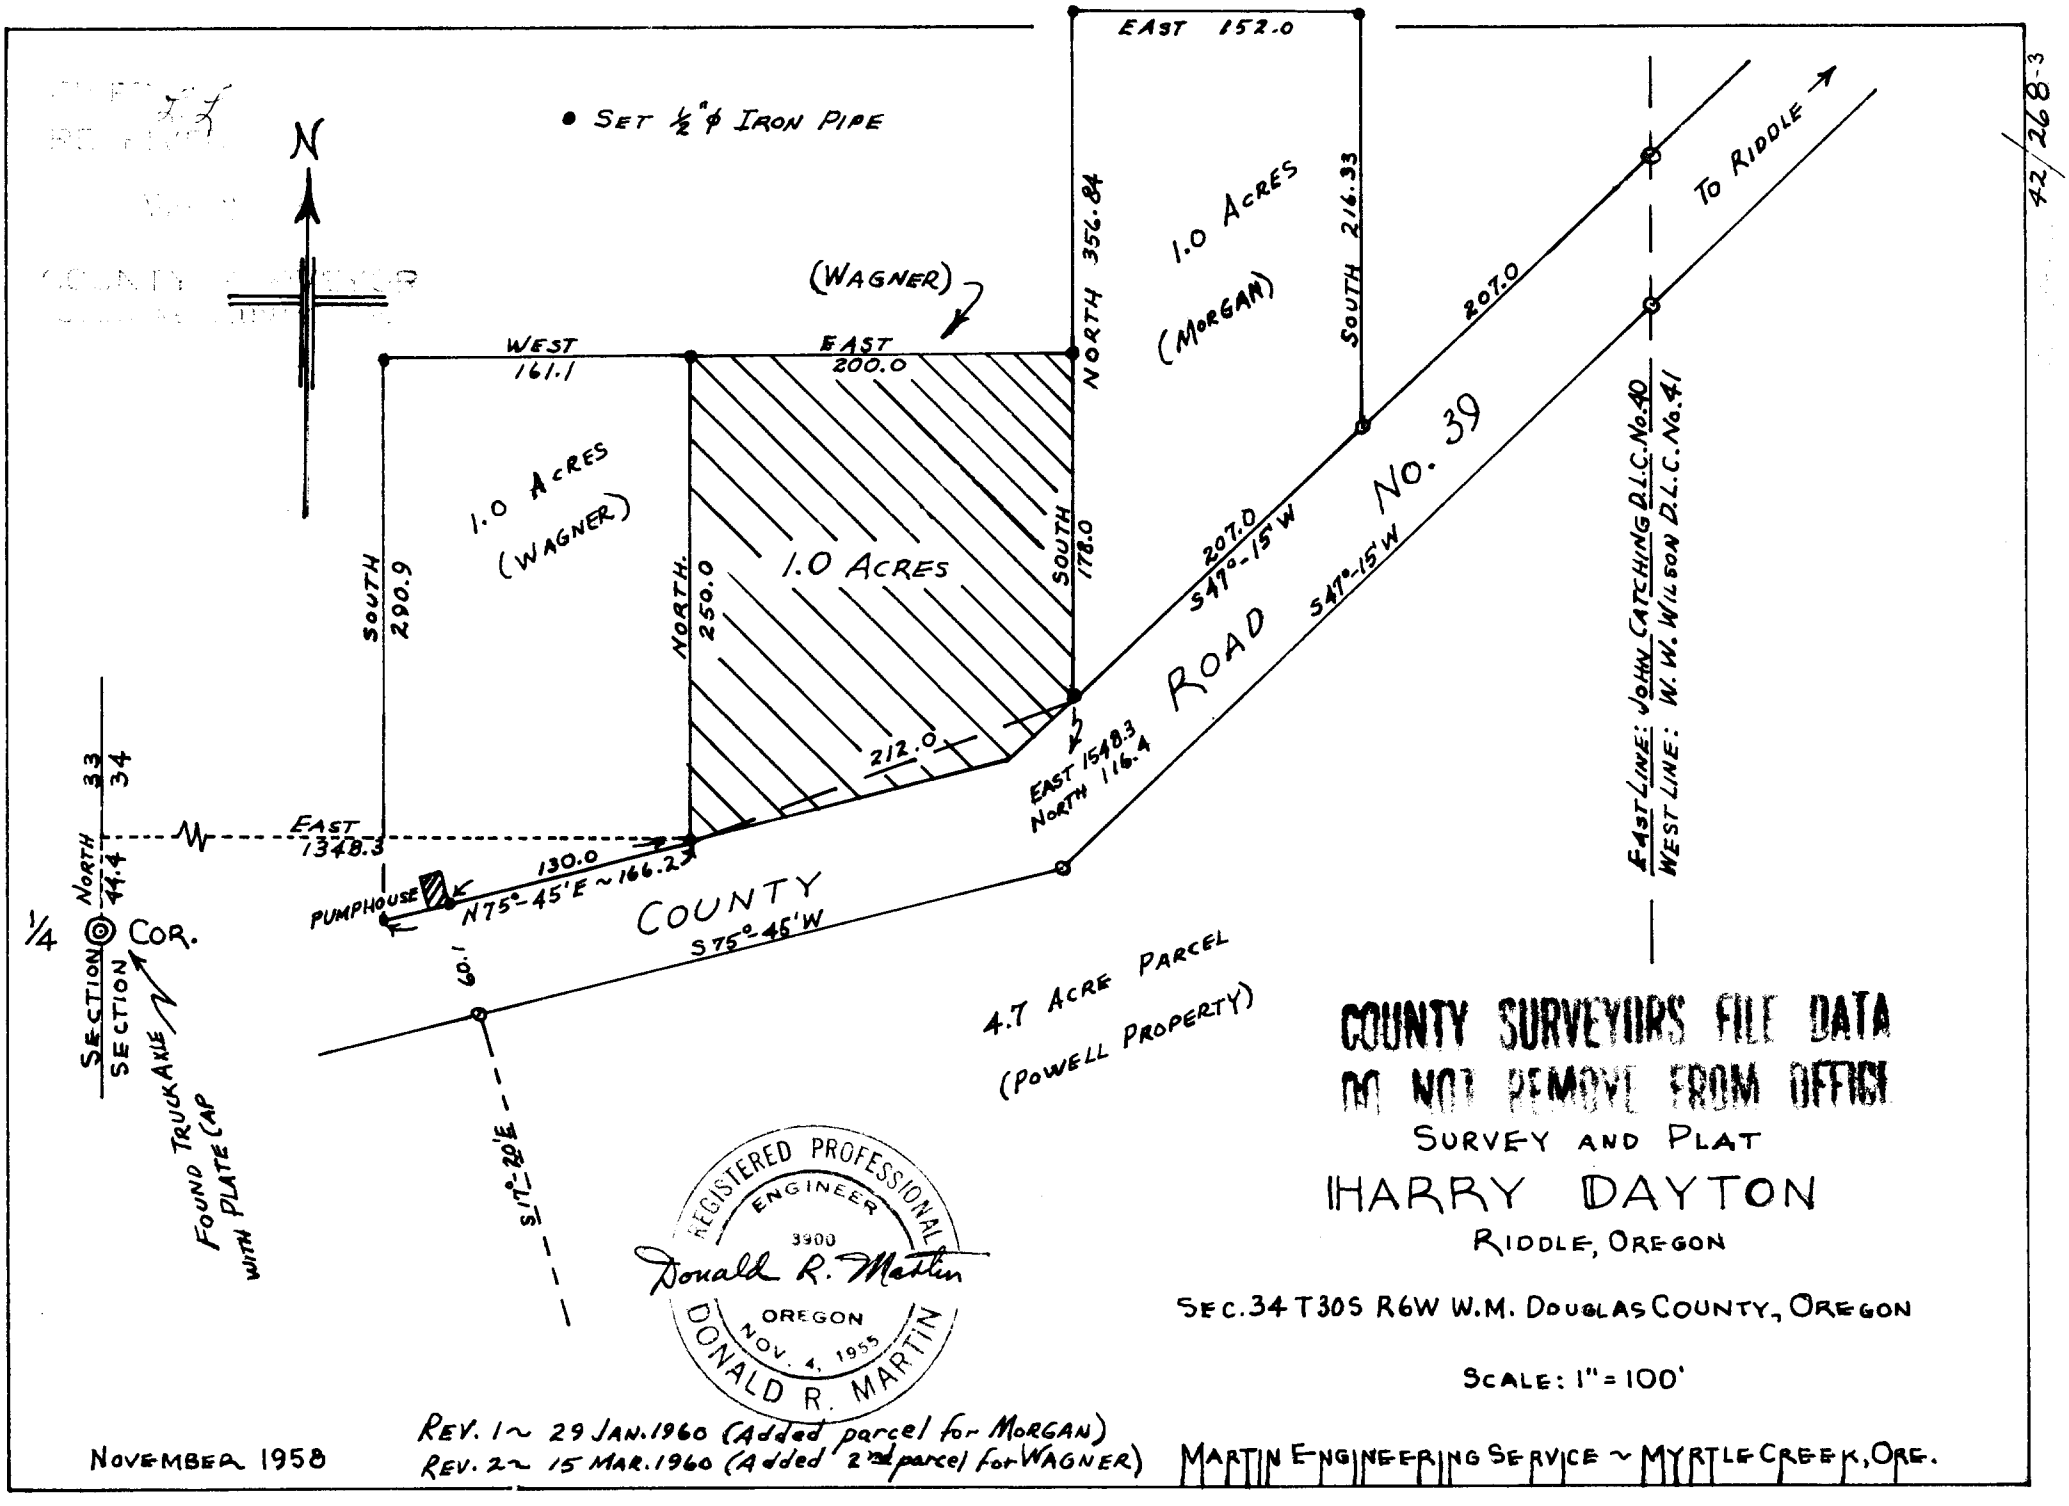

COUNTY SURVEYORS FILE DATA
DO NOT REMOVE FROM OFFICE

SURVEY AND PLAT

HARRY DAYTON

RIDDLE, OREGON

SEC. 34 T30S R6W W.M. DOUGLAS COUNTY, OREGON

SCALE: 1" = 100'

NOVEMBER 1958

REV. 1 ~ 29 JAN. 1960 (Added parcel for MORGAN)
REV. 2 ~ 15 MAR. 1960 (Added 2nd parcel for WAGNER)

MARTIN ENGINEERING SERVICE ~ MYRTLE CREEK, ORE.