

Aug. 18, 1957

Center of Section 3, T30S, R4W
W.M.

At a point where N-S & E-W
E cross I set a $\frac{3}{4}$ " 30" I.P.
from which

A 31" La. bears S41°E 34.7'
dist. mkd. $\frac{1}{4}$ S3 C.C. T30S R4W B.T.


A 33" La. bears N83°E 48.0'
dist. mkd. $\frac{1}{4}$ S3 C.C. T30S R4W B.T.

$\frac{1}{4}$ cor. bears West 2612'

$\frac{1}{4}$ cor. bears East 2660'

Witness:

R. G. Boyd

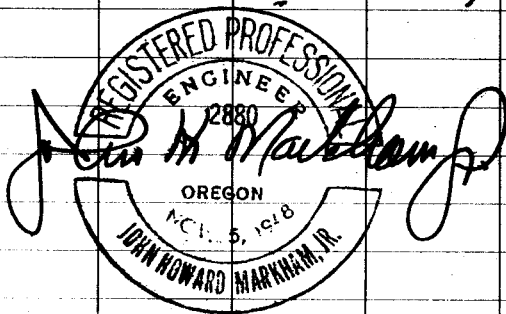

C. S. File No. 42/288-1

Work done for Steman Lbr Co.