

SURVEY

IN SECTION 13, T.32 S., R.6 W.W.M.

DOUGLAS COUNTY, OREGON.

for

GEORGE E. REYNOLDS JR.

FILED
RECEIVED

MAY 17 1957

C.S. File No. 42/2956

COUNTY SURVEYOR
DOUGLAS COUNTY, ORE.

NARRATIVE OF SURVEY

for

GEORGE M. REYNOLDS JR.


This survey was made on March 28, 1957, at the request and with the assistance of Mr. Reynolds. Used a transit, long lead chain, and range pole. Inasmuch as I was unable to find the north quarter^{corner} of this section, I made a Polaris observation at western elongation on April 1, 1957 and based the bearings on it. For the same reason I used standard subdivision dimensions where the actual dimension was unknown.

DESCRIPTION

This is the SE $\frac{1}{4}$ of the SE $\frac{1}{4}$ of the SW $\frac{1}{4}$ of Section 13, T.32 S., R.6 W.W.M., containing 10 acres more or less, in Douglas County, Oregon.

See the accompanying sketch for further information.

April 10, 1957.

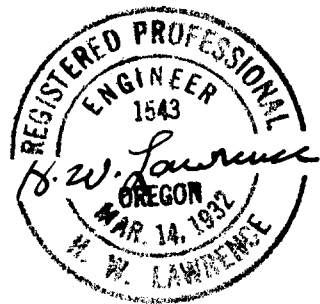

FILED
RECEIVED

MAY 17 1957

COUNTY SURVEYOR
DOUGLAS COUNTY, ORE.

C. S. File No. 42/293c