

RESTORED CORNER FOR OREGON STATE BOARD OF FORESTRY

Section corner common to Sections 9,10,15 and 16,
T. 23S, R. 10W, W.M., Coos and Douglas County, Oregon.

ORIGINAL

Post (found, down and rotted, scribes 9,10,15,23S and portion of T, 16 R10W visible), from which a:

- 6" Fir bears N20°E 34 lks.; now 18" dead tree, scribes S10 visible.
Also (not original) scribes 2 10 R Bt visible above original face.
- 10" Fir bears S39°W 30 lks.; now 35", face unexposed.
- 8" Fir bears S52°E 32 lks.; now 24", face unexposed.
- 6" Fir bears N28°W 23 lks.; now 27", exposed by unknown parties,
scribes T23 visible.

RESTORED

Var. 20°


Set 1½" x 36" galvanized iron pipe with 3" bronze cap marked
"OREGON STATE BOARD OF FORESTRY T23S R10W S9 S10 S15 S16 1957 RS 359
33 inches in ground, in mound of stone, and from which a:

- 26" Fir bears N69°E 31.3 ft.; scribed T23S R10W S10 BT.
- 27" Fir bears N 6°E 26.4 ft.; scribed RS 359

Oregon State Board of Forestry metal location poster on 27" Fir N6°E 26.4".

Dated September 13, 1957

Restored by Elbert Driver under my direction.
Elbert Driver, Engineering Aide

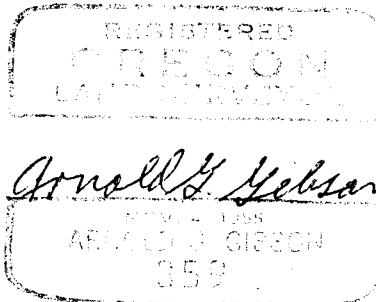

Present and witnessed by Bob Banks
Derald Timmons
Dick Rugh