

RESTORED CORNER FOR OREGON STATE BOARD OF FORESTRY

One quarter corner common to Sections 1 and 2,  
T. 23S, R. 10W, W.M., Douglas County, Oregon.

ORIGINAL

Post (now missing) from which a:

24" Fir bears N33°E 56 lks.; now 50", face grown over, bark scribes  
T23S R10W BT and  $\frac{1}{4}$  S 1, 2 visible  
6" Laurel bears West 20 lks.; now missing.

RETRACEMENT August 8, 1906 by Levi Walker

Post (found in place, scribes  $\frac{1}{4}$  S1 2 on N and T23S R10W on S visible)  
from which a:

12" Fir bears N36°W 86 lks.; now 40", face covered (bearing is N22°W.)

RESTORED

Var. 20°


Set  $1\frac{1}{2}$ " x 36" galvanized iron pipe with 3" bronze cap marked "OREGON  
STATE BOARD OF FORESTRY  $\frac{1}{4}$  S1 S2 1957 RS 359," 33 inches in ground,  
and from which a:

20" Fir bears S1°E 11.9 ft.; scribed RS 359

Oregon State Board of Forestry metal location poster on 13" Fir N39°E 4.3".

Dated September 9, 1957.

Restored by Elbert Driver under my direction.  
Elbert Driver, Engineering Aide

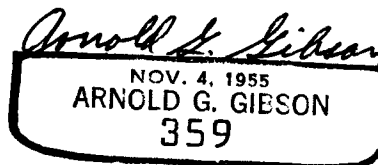

Present and witnessed by Bob Banks  
Ron Witham