

RESTORED CORNER FOR OREGON STATE BOARD OF FORESTRY

One Quarter corner common to Section 2 (North Side),
T. 23S, R. 10W, W.M., Douglas County, Oregon.

ORIGINAL

Post (found rotted off, ground level, scribes 1/4S S2 T22S R10W visible),
from which a:

48" Fir bears S80W 15 lks.; now 50" snag, bark scribes 1/4S BT visible,
also (not orig.) bark scribes 1/4S S2 T22S R10W visible.
24" Fir bears N75W 35 lks.; now 36" stump, face unexposed.

RESTORED



Var. 20 $\frac{1}{2}$ °E

Set 1 $\frac{1}{2}$ " x 36" galvanized iron pipe with 3" bronze cap marked "OREGON STATE
BOARD OF FORESTRY 1/4 S2 1958 RS 359," 33 inches in ground, and from
which a:

22" Hemlock bears S16E 15.6 ft.; scribed 1/4S 2 BT RS 359.

Dated January 23, 1958.

Restored by Elbert Driver under my direction.
Elbert Driver, Transitman

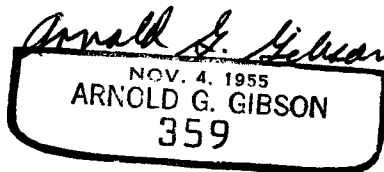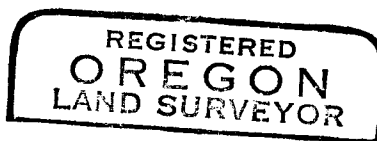

Present and witnessed by Dennis Bagger
Derald Timmons
Ron Witham

FILED
RECEIVED

FEB 24 1958

COUNTY SURVEYOR
DOUGLAS COUNTY, ORE.

C. S. File No. 42/331-3