

RESTORED CORNER FOR OREGON STATE BOARD OF FORESTRY

One Quarter corner common to Sections 2 and 3,  
T. 23S, R. 10W, W.M., Douglas County, Oregon.

ORIGINAL

Post (now missing, found rotted stake point) from which a:

- 30" Fir bears N36E 24 lks.; now 38", scribe B exposed, remainder unexposed.
- 30" Fir bears S48W 25 lks.; now 30" x 2' rotted stub.

RESTORED

Var. 20 $\frac{1}{2}$ °E


Set 1 $\frac{1}{2}$ " x 36" galvanized iron pipe with 3" bronze cap marked "OREGON STATE BOARD OF FORESTRY 1/4 S2 S3 1958 RS359," 33 inches in ground, and from which a:

- 40" Fir bears S68 3/4E 30.2 ft.; scribed RS359
- 40" Fir bears S51 $\frac{1}{2}$ W 31.8 ft.; scribed  $\frac{1}{4}$  S3 BT.

Oregon State Board of Forestry metal location poster on 40" Fir BT SW.

Dated February 7, 1958

Restored by Elbert Driver under my direction.  
Elbert Driver, Transitman

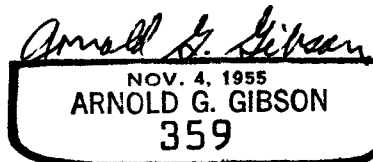

Present and witnessed by Derald Timmons  
Ron Witham  
Ron Huff

FILED  
RECEIVED

MAR 17 1958

COUNTY SURVEYOR  
DOUGLAS COUNTY, ORE.