

RESTORED CORNER FOR STATE OF OREGON-DEPARTMENT OF FORESTRY

One Quarter corner common for Section 34 (South side)
T22S, R10W, W.M., Douglas County, Oregon.

ORIGINAL

20" x 16" x 12" Stone (found in place, 1/4 on North face) from which a:

8" Maple bears S20°E 30 lks.; now missing, group of small maples growing
in place.

10" Fir bears N52W 50 lks.; now rotten stump.

RESTORED

Set 4 x 4 x 72" white painted Cedar post 2.0 ft. southwest of corner stone,
from which a:


28" Fir bears N25 $\frac{1}{2}$ W 39.6 ft.; scribed 1/4 S34 BT RS359.

18" Fir bears N46E 54.8 ft.; scribed 1/4 S 34 BT.

Oregon State Forestry Department metal location poster on 28" Fir BT.

Dated March 20, 1962

Restored by Donald L. McConnell under my direction.
Donald L. McConnell, Transitman

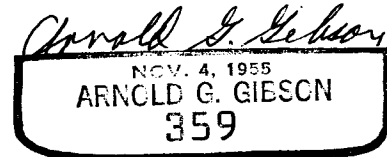

Present and witnessed by T. South
M. Pounds
D. Smith