

RESTORED CORNER FOR OREGON STATE BOARD OF FORESTRY

One Quarter corner common to Sections 4 and 9, T. 22S,
R. 11W, W.M., Douglas County, Oregon.

ORIGINAL

Post (now missing, found rotted stake point in place and 4x4x4.8" white
painted cedar post 6" from stake hole).

4" Cherry bears N2E 27 lks.; now missing.
4.8" Fir bears S65W 4.4 lks.; now 5.6", uncovered scribes S 4, remainder
unexposed.

RESTORED

Var. 20 1/2 E

Set 1 1/2" x 36" galvanized iron pipe with 3" bronze cap marked "OREGON STATE
BOARD OF FORESTRY 1/4 S4 S9 1958 RS 359," 33 inches in ground, and from
which a:


16" Fir bears N54E 10.0 ft.; scribed 1/4 S4 BT.
12" Fir bears S61 E 6.5 ft.; scribed RS 359

Reset 4x4x4.8" white painted Cedar post 1.5' SW of pipe.

Oregon State Board of Forestry metal location poster on 8" Fir S31W 7.0'

Dated January 3, 1958

Restored by Elbert Driver under my direction.
Elbert Driver, Transitman

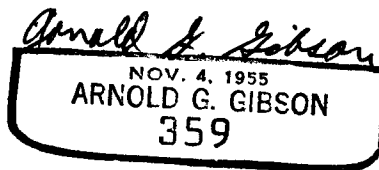

Present and witnessed by Derald Timmons
Ron Witham

FILED
RECEIVED

FEB 24 1958

COUNTY SURVEYOR
DOUGLAS COUNTY, ORE.

C. S. File No. 42/340