

ESTABLISHED CORNER FOR OREGON STATE BOARD OF FORESTRY

West One Sixteenth corner common to Sections 3 and 10,  
T. 22S, R. 11W, W.M., Douglas County, Oregon.

ESTABLISHED

Var.  $20\frac{1}{2}^{\circ}$ E

Set  $1\frac{1}{2}$ " x 36" galvanized iron pipe with 3" bronze cap marked "OREGON STATE BOARD OF FORESTRY W 1/16 S3 S10 1958 RS 359," 33 inches in ground, in mound of stone, and from which a:

30" Fir bears S61 $\frac{1}{2}$ W 12.1 ft.; scribed W 1/16 S10 BT

19" Fir bears N12W 29.3 ft.; scribed W 1/16 S3 BT


26" Fir bears S56E 22.0 ft.; scribed RS 359

Set 4x4x48" white painted Cedar post 1.5' SE of pipe.

Oregon State Board of Forestry metal location poster on 30" Fir BT.

Dated January 27, 1958.

Established by Elbert Driver under my direction.  
Elbert Driver, Transitman

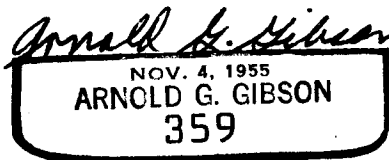

Present and witnessed by Derald Timmons  
Ron Witham

FILED  
RECEIVED

FEB 24 1958

COUNTY SURVEYOR  
DOUGLAS COUNTY, ORE.