

REESTABLISHED CORNER FOR OREGON STATE BOARD OF FORESTRY
(See official plat)
Closing corner common to Sections 2 and 3 (North side),
T. 23S, R. 10W, W.M., Douglas County, Oregon.

ORIGINAL

Post (now missing) from which a:

- 20" Hemlock bears S58E 64 lks.; now missing, pieces of broken up stump, with back cast of scribe 2 visible, found nearby.
- 24" Alder bears S86W 23 lks.; now missing, possible original log nearby, no markings found.

REESTABLISHED

Var. 20 1/2° E

Set 1 1/2" x 36" galvanized iron pipe with 3" bronze cap marked "OREGON STATE BOARD OF FORESTRY T22S R10W S35 T23S R10W S2 S3 CC 1958 RS 359," 33 inches in ground, in mound of stone, and from which a:


- 24" Hemlock stp. bears S47W 92.5 ft.; scribed T23S R10W S3 BT.
- 18" Hemlock bears N38 1/2 W 58.5 ft.; scribed RS 359.

Set 4 x 4 x 72" white painted Cedar post 1.0' SE of pipe.

Oregon State Board of Forestry metal location poster on 18" Hemlock BT.
South 1/4 corner of Section 35 bears N88° 50'E 88.3' (proportioned distance)
Center of road bears S39E 79.0'.

Dated April 4, 1958.

Reestablished by Elbert Driver under my direction.
Elbert Driver, Transitman

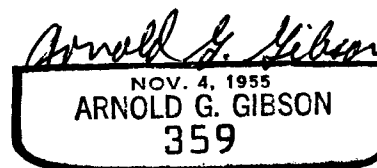

Present and witnessed by Ron Witham
Floyd Peachee

FILED
RECEIVED

APR 25 1958

COUNTY SURVEYOR
DOUGLAS COUNTY, ORE.
C. S. File No. 42/353