

ESTABLISHED CORNERS FOR OREGON STATE BOARD OF FORESTRY

(See official plat)

Witness corner for center one quarter corner for Section 2 (on West side of Loon Lake), T. 23S, R. 10W, W.M., Douglas County, Oregon.

ESTABLISHED

Set $1\frac{1}{2}$ " x 36" galvanized iron pipe with 3" bronze cap marked "OREGON STATE BOARD OF FORESTRY WC $0\frac{1}{4}$ S2 579.3 Ft. 1958 RS 359," 33 inches in ground, in mound of stone, and from which a:

42" Fir bears N50 $\frac{1}{2}$ W 137.3 ft.; scribed X BT.

18" Myrtle (clump) bears S15E 57.5 ft.; scribed X BT RS 359.

A 27' x 16' x 7 $\frac{1}{2}$ ' high rock bears S12 $\frac{1}{2}$ E 67.3 ft.

Set 4 x 4 x 72" white painted Cedar post 1.5 ft. SW of pipe.

Oregon State Board of Forestry metal location poster on 18" Myrtle BT.

Also poster on 4 x 4 x 72" white painted Cedar post N89° 44'W 29.0' on East edge of road.

West shore of Loon Lake bears S89° 44'E 167.0 Ft.

Witness corner for center one quarter corner for Section 2 (on East side of Loon Lake), T. 23S, R. 10W, W.M., Douglas County, Oregon.

ESTABLISHED

Set $1\frac{1}{2}$ " x 36" galvanized iron pipe with 3" bronze cap marked "OREGON STATE BOARD OF FORESTRY WC $0\frac{1}{4}$ S2 381.9 Ft. 1958 RS359," 33 inches in ground, in mound of stone, and from which a:

81" Fir bears N39E 9.6 ft.; scribed X BT RS359.

21" Fir bears S46 $\frac{1}{2}$ W 29.0 ft.; scribed X BT.

Set 4 x 4 x 72" white painted Cedar post 1.5 ft. SE of pipe.


Oregon State Board of Forestry metal location poster on 15" Hemlock S3E 12.2'

Also poster on 4 x 4 x 72" white painted Cedar post 243.2 ft. S89° 44'E on East bank county road.

East shore of Loon Lake bears N89° 44'W 63.0 ft.

April 4, 1958.

Established by

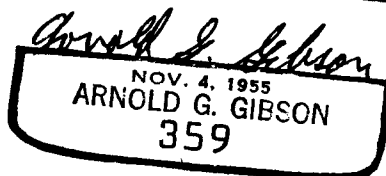

Present and witnessed by E. Driver
D. Timmons
R. Witham
F. Peachee

FILED
RECEIVED

APR 25 1958

COUNTY SURVEYOR
DOUGLAS COUNTY, ORE.

C. S. File No. 42/353