LOT 16 · BL. 1 · SUN-DALE VILLAGE · ROSEBURG · ORE.

HAMILTON AVE.

Adrian K. Lessert.

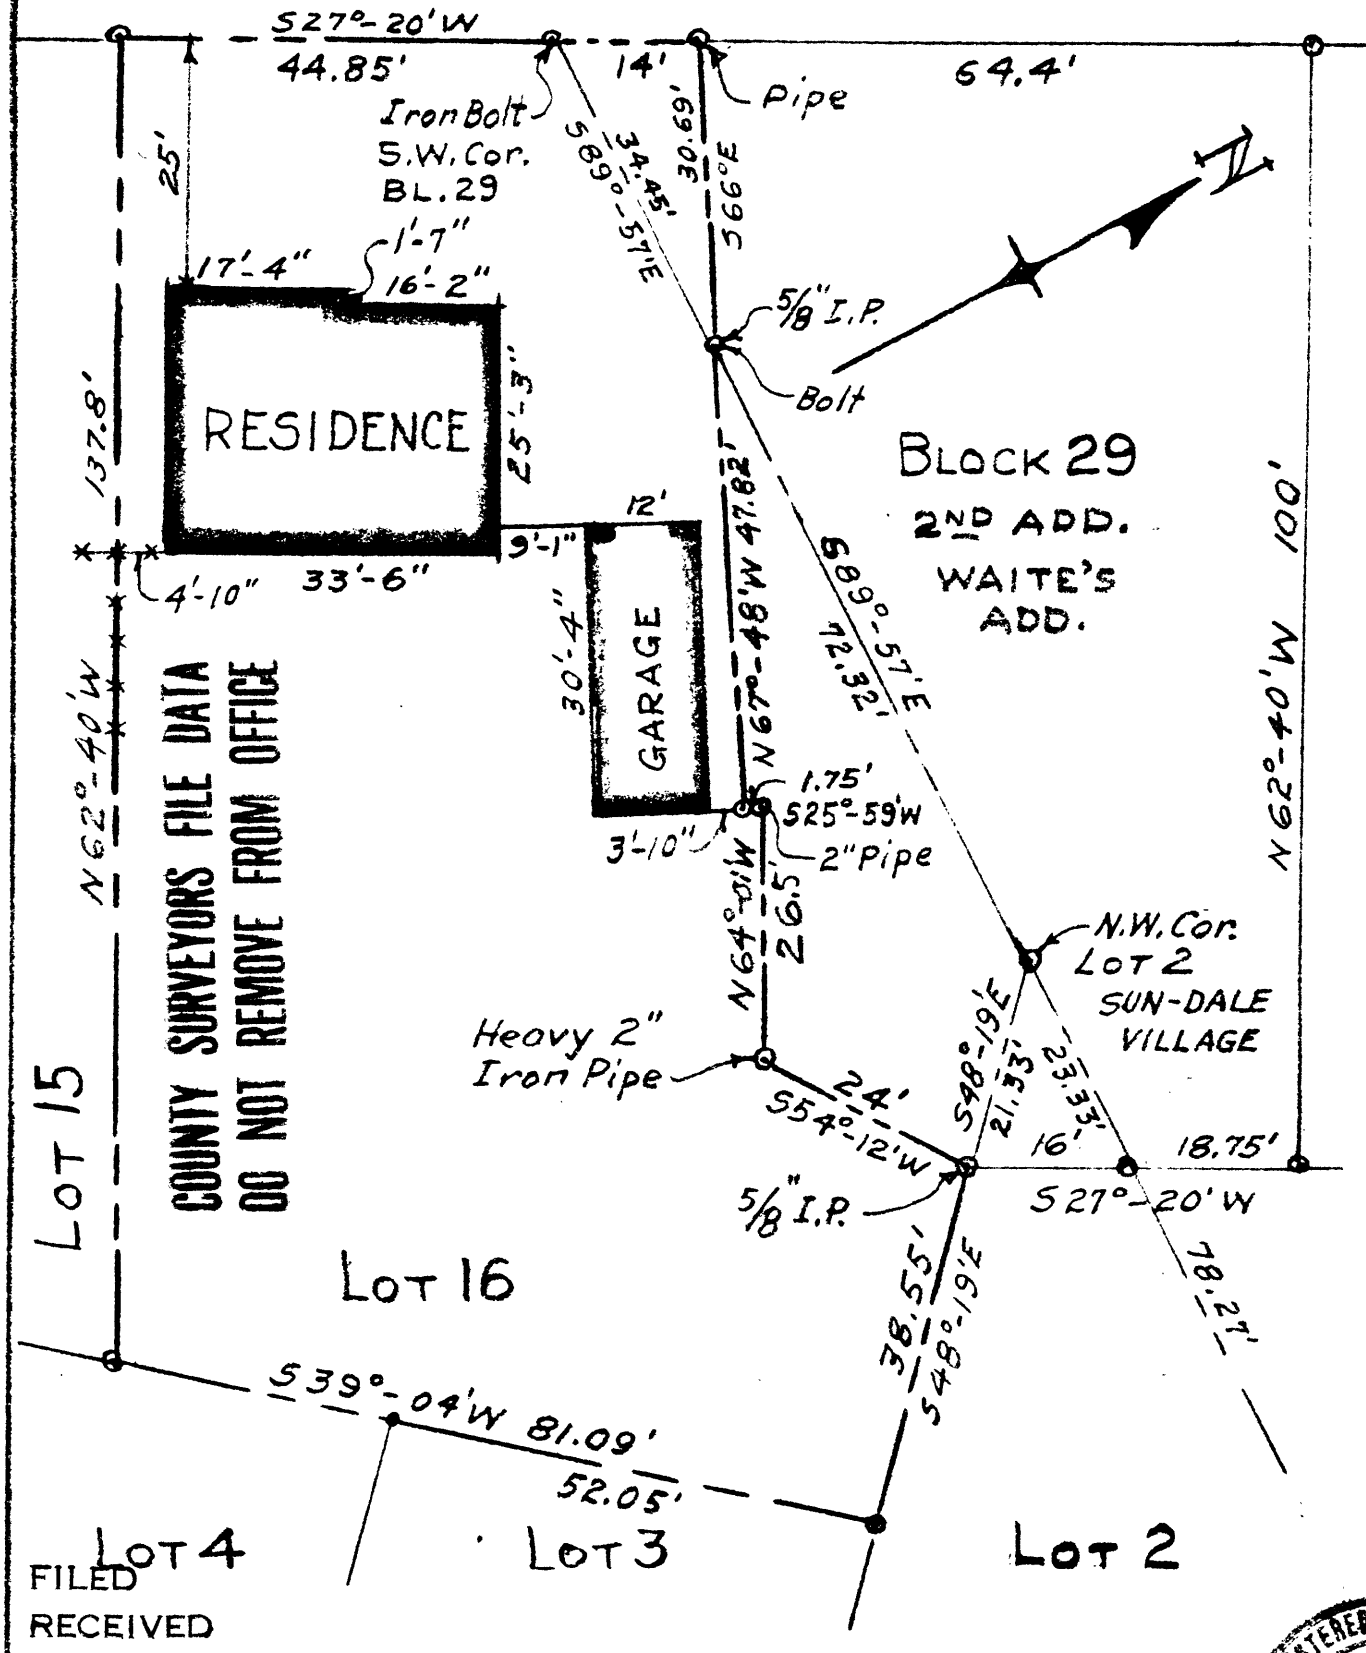

I, James R. Daugherty, hereby certify that I have surveyed the Lot shown on the above MAP and found the RESIDENCE thereon to be located completely within the Property Lines as shown.

FILED
RECEIVED

JUL 24 1958

COUNTY SURVEYOR
DOUGLAS COUNTY, ORE.

Scale 1" = 20'

JULY 1958.

JAMES R. DAUGHERTY

CIVIL-SANITARY ENGINEER

ROSEBURG · ORE.

REGISTERED PROFESSIONAL ENGINEER
2333
James R. Daugherty
OREGON
NOV. 10, 1948
JAMES R. DAUGHERTY

C.S. File No. 92/379