

Sept. 17, 1959

$\frac{1}{16}$ section corner West Sec 1 & 12
T31S R3W W.M.

At midpoint set $\frac{3}{4} \times 30$ " I.P.

from which

14" La bears N24E 21.0' mkd. $\frac{1}{16}$ S1 B.T.

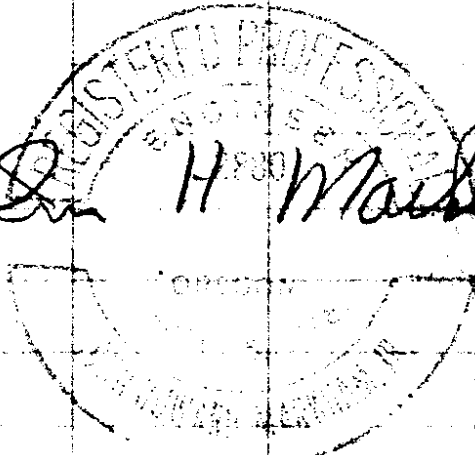
10" La. bears N38W 33.8' mkd. $\frac{1}{16}$ SW S1 B.T.

12" La. bears S35W 22.0' mkd. $\frac{1}{16}$ SW S12 BT

Sec. Cor. 1-2-11-12 bears West 1326.0'

$\frac{1}{4}$ cor. $\frac{1}{12}$ bears East 1326.0'

Witness: R. G. Boyd

H. Marshall

Work done for Starnan Lbr Co

✓ C. S. File No. 22/392