

RESTORED CORNER FOR OREGON STATE BOARD OF FORESTRY

Township corner common to Sections 1 and 6,
T. 23S, R. 11 & 12W, W.M., Coos & Douglas Counties,
Oregon.

ORIGINAL

Post (now missing, $\frac{1}{2}$ " iron rod set in place by Elliott State Forest Survey)
from which a:

20" Maple bears N67W 50 lks.; now missing, clump in place.

10" Maple bears N82E 40 lks.; now 15", chopped out by unknown party, no
scribes visible.

Closing Township corner bears West 480 lks.; in place (see restoration
records).

RESTORED by Clifford Stephens, 1952.

8" Fir bears S81E 39.6 ft.; now 13", scribes BT S6 T2 R11 visible.

RESTORED

Var. 20 $\frac{1}{2}$ °E

Set 1 $\frac{1}{2}$ " x 36" galvanized iron pipe with 3" bronze cap marked "OREGON STATE BOARD
OF FORESTRY T22S R11W S31 T23S R11W R12W S1 S6 1958 RS 359", 33 inches in
ground over $\frac{1}{2}$ " iron rod, and from which a:

17" Myrtle (in clump) bears S24W 58.6 ft. bark scribed T23S R12W S1 BT.


28" Fir bears N49E 67.6 ft.; scribed RS 359.

Set 4 x 4 x 72" white painted Cedar post 1.0' NW of pipe.

Oregon State Board of Forestry metal location poster on 8" Fir BT.

Dated September 15, 1958.

Restored by Elbert Driver under my direction.
Elbert Driver, Transitman

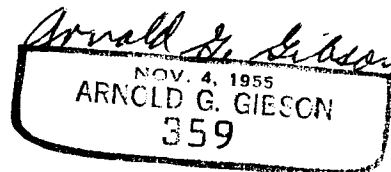

Present and witnessed by Robert Banks
Derald Timmons