

RESTORED CORNER FOR OREGON STATE BOARD OF FORESTRY

One Quarter corner common to Section 6 (North Side), T. 23S, R. 11W, W.M., Coos and Douglas Counties, Oregon.

ORIGINAL

Post (now missing) from which a:

10" Myrtle bears N2E 115 lks.; now 14" clump in place, no scribes visible.  
50" Fir bears S72E 235 lks.; now 32" x 5 ft. high rotted and burnt stub.  
Closing corner 31 & 32 bears S88° 55'E 39.6 ft.; in place (see records for restoration).

NOTE: The Elliott State Forest survey party of 1939 found this corner.

RESTORED

Var. 19 $\frac{1}{2}$ °E


Set 1 $\frac{1}{2}$ " x 36" galvanized iron pipe with 3" bronze cap marked "OREGON STATE BOARD OF FORESTRY 1/4 S6 1958 RS 359", 33 inches in ground, and from which a:

13" Fir bears S2W 78.7 ft.; scribed 1/4 S6 BT.  
15" Fir bears S30W 92.0 ft.; scribed 1/4 S6 BT RS 359.

Set 4 x 4 x 72" white painted Cedar post 1.5' SW of pipe.  
Oregon State Board of Forestry metal location poster on 32" Myrtle N46 $\frac{1}{2}$ E 26.5'

Dated September 15, 1958

Restored by Elbert Driver under my direction.  
Elbert Driver, Transitman

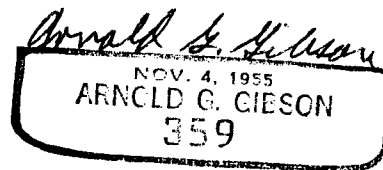

Present and witnessed by Derald Timmons