

RESTORED CORNER FOR OREGON STATE BOARD OF FORESTRY

Section corner common to Sections 5 and 6 (North side), T. 23S, R. 11W, W.M., Coos & Douglas Counties, Oregon.

ORIGINAL

Post (now missing) from which a:

- 40" Cedar bears N32E 85 lks.; now missing, roots in place.
- 40" Fir bears S52W 50 lks.; now rotted and burnt up-root.
- 60" Fir bears S57E 298 lks.; now 54" burnt and rotted stub, scribes T23S R11W S5 remaining.
- 8" Alder bears N20W 46 lks.; now missing.

RESTORED by William R. Whipple 1893

Stone 14 x 12 x 6" (found in place, 5 notches on the East) from which a:

- 50" Burnt Fir bears N87E 115 lks.; now missing.

RESTORED

Var. 19 $\frac{1}{2}$ °E


Built mound of stone around original stone, from which a:

- 11" Fir bears S89 $\frac{1}{2}$ E 59.1 ft.; scribed T23S R11W S5 BT.
- 20" Fir bears S37W 94.2 ft.; scribed T23S R11W S6 BT.
- 5" Fir bears N72W 10.5 ft.; scribed RS359.

Oregon State Board of Forestry metal location poster on above 5" Fir.
Set 4 x 4 x 72" white painted Cedar post 1.5' SE of pipe.

Dated September 15, 1958

Restored by Elbert Driver under my direction.
Elbert Driver, Transitman

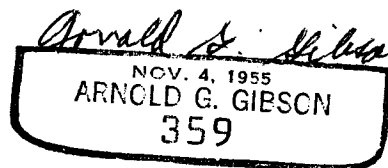

Present and witnessed by Robert Banks
Derald Timmons
Ron Witham