

RESTORED CORNER FOR OREGON STATE BOARD OF FORESTRY

Closing Township corner common to Sections 31 & 36, T. 22S, R. 11 & 12 W, W.M., Coos & Douglas Counties, Oregon.

21 - T22R11

ORIGINAL

Stone 24" x 12" x 6" (found in place with 6 notches on the North) from which a:

- 20" Dead Cedar bears N54E 18 lks.; now 16" burnt and rotted uproot, faint scribe marks visible.
- 24" Cedar stub bears N85 $\frac{1}{2}$ W 118 lks.; now missing.
- 36" Fir stub bears S71E 69 lks.; now rotted and burnt uproot.

RESTORED

Var. 20 $\frac{1}{2}$ °E


Built mound of stone around original stone, from which a:

- 25" Fir bears N17E 19.4 ft.; scribed T22S R11W S31 CC BT.
- 29" Fir bears N30W 103.6 ft.; scribed T22S R12W S36 CC BT.
- 31" Fir bears S20E 25.8 ft.; scribed RS 359.

Oregon State Board of Forestry metal location poster on 25" Fir BT.  
Set 4 x 4 x 72" white painted Cedar post 1.0' SE of stone.

Dated September 15, 1958

Restored by Elbert Driver under my direction.  
Elbert Driver, Transitman

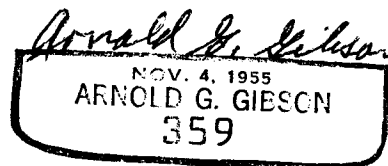

Present and witnessed by Robert Banks  
Derald Timmons

Sec. 710. 19, 20, 21, 31, 32

C.S. File No. 42/403-5