

RESTORED CORNER FOR OREGON STATE BOARD OF FORESTRY

Closing Section corner common to Sections 31 &
32, T. 22S, R11W, W.M., Coos and Douglas Counties,
Oregon.

ORIGINAL

Post (now missing) from which a:

14" Maple bears N63E 135 lks.; now 24" clump.
14" Cherry bears N20W 228 lks.; now 16", faint bark scribe visible.
50" Burnt Fir bears S32E 189 lks.; now rotted and burnt stub, 6 ft. high.
North $\frac{1}{4}$ Section 6 bears N88° 55' W 39.6 ft.; in place (see records for
restoration).

RESTORED

Var. 19 $\frac{1}{2}$ °E



Set 1 $\frac{1}{2}$ " x 36" galvanized iron pipe with 3" bronze cap marked "OREGON STATE BOARD
OF FORESTRY T22S R11W CC S31 S32 T23S R11W S6 1958 RS359", 33 inches in ground,
and from which a:

21" Alder bears S38E 19.0 ft.; bark scribed RS 359.
10" Myrtle bears N50E 8.0 ft.; bark scribed T22S R11W S32 BT.
26" Maple bears N17W 105.2 ft.; scribed T22S R11W S31 BT.

Set 4 x 4 x 72" white painted Cedar post 1.5' NW of pipe.
Oregon State Board of Forestry metal location poster on 10" Myrtle BT.

Dated September 15, 1958

Restored by Elbert Driver under my direction.
Elbert Driver, Transitman

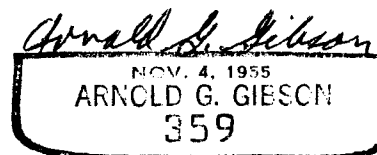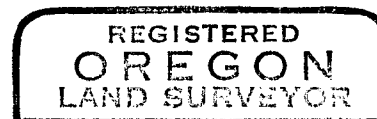

Present and witnessed by Derald Timmons

✓ ✓

42/403^u