

RESTORED CORNER FOR OREGON STATE BOARD OF FORESTRY

Closing corner common to Sections 17 and 20 (East side) T22S, R11W, W.M., Douglas County, Oregon.

ORIGINAL

Stone 14" x 12" x 7" (found a badly weathered stone in place, no trace of notches) from which a:

30" Fir bears S2W 215 lks.; now a rotted stub.

20" Cherry bears N42W 118 lks.; missing.

60" Fir bears N86E 65 lks.; now 73", portion of face exposed by unknown party, scribe 1 visible, remainder unexposed.

RESTORED

Var. 20°E

Set 1½" x 36" galvanized iron pipe with 3" bronze cap marked "OREGON STATE BOARD OF FORESTRY T22S R11W S17 S20 S21 CC 1960 RS359", 14 inches in ground down to solid rock, in mound of stone, and from which a:


14" Fir bears S41½W 16.3 ft.; scribed T22S R11W S20 CC BT.

25" Fir bears N17E 6.7 ft.; scribed RS359.

Oregon State Board of Forestry metal location poster on 14" Fir BT.  
Corner falls on top of spur ridge sloping North.

Dated July 18, 1960

Restored by Elbert Driver under my direction.  
Elbert Driver, Transitman

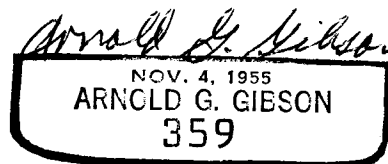

Present and witnessed by John Hollingsworth  
Harold Baughn