

RESTORED WITNESS POINT FOR OREGON STATE BOARD OF FORESTRY

Line tree common to Sections 25 and 30, T22<sup>S</sup>, R11 & 12W,  
W.M., Douglas County, Oregon.

ORIGINAL

10" Fir line tree at 36.27 chains South on East boundary of Section 25 with  
2 notches on N and S sides (now 20" in place, exposed one notch on N side  
67 years old).

Top of ridge, course East, at 36.40 chs.; in place.

RESTORED

Scribed line tree as Witness Point, WP S30 on East side, WP s25 RS359 on West  
side, from which a:


48" Fir bears N62 $\frac{1}{2}$ W 52.0 ft.; scribed WP S30 BT.

43" Fir bears N46 $\frac{1}{2}$ E 18.0 ft.; scribed WP S30 BT.

Oregon State Board of Forestry metal location poster on 13" Hemlock N72W 9.8 ft.

Dated December 16, 1960

Restored by

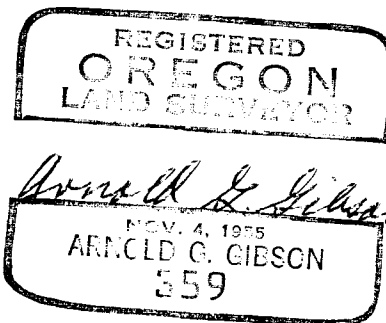

Present and witnessed by E. Driver  
J. Hollingsworth