

RESTORED WITNESS POINT FOR OREGON STATE BOARD OF FORESTRY

Line tree common to Sections 19 and 24, T22S, R11 & 12W,  
W.M., Douglas County, Oregon.

ORIGINAL

30" Fir Line tree at 73.84 chains South on the East boundary of Section 24 with  
2 notches on North and South sides (now 48", in place, exposed one notch on  
South side, 67 years old).

RESTORED

Var. 20 $\frac{1}{2}$ °E

Scribed Line tree as Witness Point, WP S19 on East side and WP S24 RS359 on West  
side, from which a:


60" Fir bears S31 $\frac{1}{2}$ W 31.0 ft.; scribed WP S24 BT.

52" Fir bears N66 $\frac{1}{2}$ E 39.4 ft.; scribed WP S19 BT.

Oregon State Board of Forestry metal location poster on 60" Fir BT.

Dated December 20, 1960

Restored by

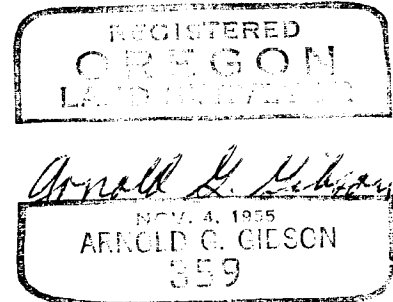

Present and witnessed by Elbert Driver  
John Hollingsworth

42/403-12