

RESTORED CORNER FOR OREGON STATE BOARD OF FORESTRY

Section corner common to Sections 24 and 25 (East side), T22S, R12W, W.M., Douglas County, Oregon.

ORIGINAL

Post (now missing) from which a:

- 14" Chittem bears S61W 14 lks.; now missing.
- 5" Hazel bears N84W 5 lks.; now 5", down and rotted, no scribes visible.
- 20" Alder bears N40W 22 lks.; now 24", exposed portion of T and other scribes, bears N40E.
- 30" Fir Line tree bears North 6.16 chains; found in place.
- Ridge, course East, bears South 1.80 chains; in place.
- 14" Fir Line tree bears South 7.63 chains; found in place.

RESTORED

Var. 20 $\frac{1}{2}$ °E

Set 1 $\frac{1}{2}$ " x 36" galvanized iron pipe with 3" bronze cap marked "OREGON STATE BOARD OF FORESTRY T22S R11W R12W S19 S24 S25 1960 RS359", 30 inches in ground, and from which a:


- 45" Fir bears S73W 15.3 ft.; scribed T22S R12W S25 BT RS359.
- 27" Cedar bears N56W 47.3 ft.; scribed T22S R12W S24 BT.
- 24" Original Alder BT bears N40E 14.5 ft.; scribed BT (above original face).

Oregon State Board of Forestry metal location poster on 27" Cedar BT.

Set 4" x 4" x 72" white painted Cedar post 1.5' SE of pipe.

Dated December 20, 1960

Restored by

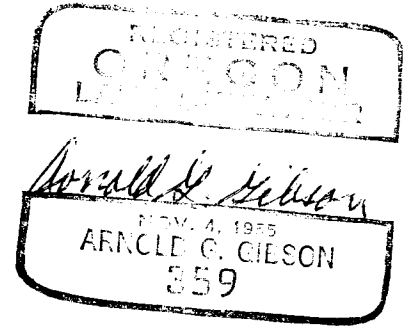

Present and witnessed by Elbert Driver
John Hollingsworth