

RESTORED CORNER FOR OREGON STATE BOARD OF FORESTRY

Angle Point corner common to Sections 25 and 30
(Whipple's 1893 East 1/4 corner 25), T22S, R11
and 12W, W.M., Douglas County, Oregon.

ORIGINAL

Stone 14 x 10 x 6 (now missing) from which a:

- 8" Cedar bears S65W 25 lks.; now 22", exposed original scribe 4,
recent scribes BT 1/4 S25 T22 R12W 399 outside.
- 6" Chittum bears S22E 29 lks.; missing.
- Ridge, course East, bears North 360 lks.; in place.
- 10" Line tree bears North 373 lks.; in place (restored as WP).

NOTE: Also found a 5/8" iron pin S16E 3.5 ft. and a 22" Cedar N49 1/2 W
25.4 ft. scribed BT 1/4 S25 T22S R11.

RESTORED

Set 1 1/2" x 36" galvanized iron pipe with 3" bronze cap marked "OREGON
STATE BOARD OF FORESTRY AP S25 S30 1960 RS359", 35 inches in ground,
in mound of stone, and from which a:


30" Cedar bears N26W 45.9 ft.; scribed AP S25 BT RS359.

Oregon State Board of Forestry metal location poster on original 8"
Cedar BT.

NOTE: We erased the recent scribes "1/4" on above trees S65W and
N49 1/2 W.

Dated January 18, 1961

Restored by

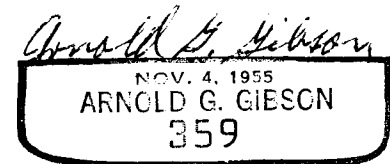

FILED Present and witnessed by E. Driver
RECEIVED J. Hollingsworth

FEB 3 1961

COUNTY SURVEYOR
DOUGLAS COUNTY, ORE.