

RESTORED CORNER FOR OREGON STATE BOARD OF FORESTRY

Section corner common to Sections 11, 12, 13 and
14, T22S, R11W, W.M., Douglas County, Oregon.

ORIGINAL

Stone 12" x 10" x 5" (missing, area now bare rock) from which a:

- 8" Fir bears N15E 36 lks.; now 16", original face overgrown, cut through original face also overgrown.
- 12" Fir bears S29E 100 lks.; now 38", faces overgrown (bearing S39E).
- 12" Alder bears S80W 60 lks.; now missing, point falls in slide area.
- 24" Alder bears N52W 73 lks.; now missing, point covered by slide.

Bottom of gulch, course NE, bears West 1 chain; now in place.
Bottom of gulch, course NE, bears North 2.16 chains; now in place.

RESTORED

Scribed X on bedrock for corner point from which a:

- 13" Cedar bears S69 $\frac{1}{2}$ W 32 ft.; scribed T22S R11W S14 BT.
- 10" Cedar bears N33 $\frac{1}{2}$ W 42.9 ft.; scribed T22S R11W S11 BT RS359.

30 ft. by 5 ft. high rock ledge bears S45E 11.4 ft.; scribed X B0.


Oregon State Board of Forestry metal location poster on 10" Cedar BT.

Dated April 21, 1961

Restored by *George E. Shore, Jr.* under my direction.
George E. Shore, Jr., Transitman



Present and witnessed by R. Banks
T. South

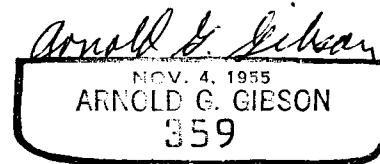

FILED
RECEIVED

MAY 17 1961

COUNTY SURVEYOR
DOUGLAS COUNTY, ORE.