

RESTORED CORNER FOR OREGON STATE BOARD OF FORESTRY

Section corner common to Sections 19, 20, 29 and 30, T22S, R11W, W.M., Douglas County, Oregon.

ORIGINAL

Stone 12" x 10" x 8" (now missing) from which a:

- 4" Chittum bears N87E 18 lks.; now missing, uproot hole in place.
- 40" Fir bears S54E 32 lks.; now 61", scribes S2 visible.
- 50" Fir bears S56W 64 lks.; now 70", scribes S30 visible.
- 7" Crabapple bears N85W 18 lks.; now rotten stump.

RESTORED

Var. 20 1/2°

Set 1 1/2" x 36" galvanized iron pipe with 3" bronze cap marked "OREGON STATE BOARD OF FORESTRY T22S R11W S19 S20 S29 S30 1961 RS359", 33 inches in ground, in mound of stone, and from which a:


- 21" Alder bears N7 3/4°W 37.3 ft.; scribed in bark T22S R11W S19 BT.
- Original 40" Fir bears S54E 21.1 ft.; scribed BT (near bottom).
- Original 50" Fir bears S56W 42.2 ft.; scribed RS359 BT (near bottom).

No other trees available.

Oregon State Board of Forestry metal location poster on original 40" Fir BT.
Set 4" x 4" x 6' white painted Cedar post 2.0 ft. South of corner pipe.

Dated April 25, 1961

Restored by George E. Shore, Jr. under my direction.
George E. Shore, Jr., Transitman

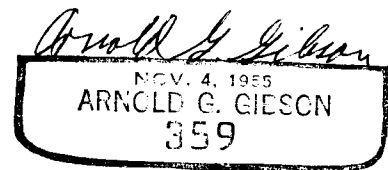

Present and witnessed by P. Lewellyn
T. South
W. S. McCleve

FILED
RECEIVED

MAY 17 1961

COUNTY SURVEYOR
DOUGLAS COUNTY, ORE.