

Dec. 18, 1958

1/4 Cor. 1-12 T305 R2W W.M.
as det. by O.B.T.S

7" Fir bears S48E 13.2' O.B.T. f.d. scribe

8" Fir bears N40E 6.0' O.B.T.

At cor. pt. f.d. 14" Cedar mkd.
on North face - I rescribe on East
face 1/4 S f set 1 x 30" l.P. at
base of tree.

from which

7" Fir bears N69E 11.2' dist, mkd.

1/4 S 12 B.T.

5" Fir bears S30W 9.0' dist.


mkd. 1/4 S 12 B.T.

5" Yew bears N14W 10.2' dist.

mkd. 1/4 S 1 B.T.

Road bears East 450.0' dist.

Witness: R.G. Boyd

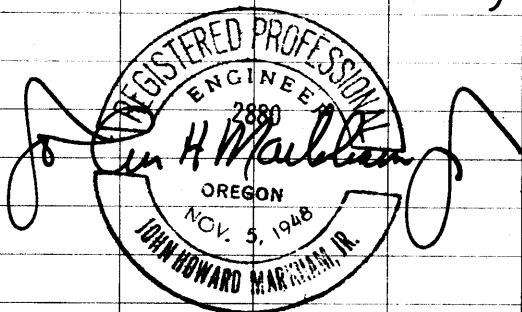

Work done for Stoman Lbr. Co
C. S. File No. 82/421-3